

Orig - State Corp. Comm. ✓
 Copy - B. A. Conner - 357 FPB
 Copy - Mary Crump - Okla. City
 Copy - Well File

STATE OF KANSAS
 STATE CORPORATION COMMISSION
 200 Colorado Derby Bldg.
 Wichita, Kansas 67202

15-083-21030-0000

RECEIVED
 STATE CORPORATION COMMISSION
 Form CP-4
 REG. 12-15-80


DEC 28 1982

CONSERVATION DIVISION
 Wichita Kansas

WELL PLUGGING RECORD

Give All Information Completely
 Make Required Affidavit

COUNTY Hodgeman SEC. 15 TWP. 21 RGE. 21 E/W
 Location as in quarters or footage from lines:
1980' FEL and 1980' FSL SE/4

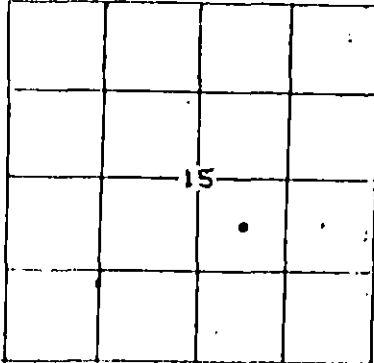

Locate Well
 correctly on above
 Section Platt.

Lease Owner Phillips Petroleum Company
 Lease Name Huling - AB Well No. 8
 Office Address Box 287, Great Bend, Kansas 67530
 Character of Well (Completed as Oil, Gas or Dry Hole): Dry Hole
 Date Well Completed December 23, 1982
 Application for plugging filed December 23, 1982 (Verbal)
 Plugging commenced December 23, 1982
 Plugging completed December 23, 1982
 Reason for abandonment of well or producing formation Dry Hole

Was permission obtained from the Conservation Division or it's
 Agent's before plugging was commenced? Yes - verbal (Steve Durrant)

Name of Conservation Agent who supervised plugging of this well Steve Durrant
 Producing formation --- Depth to top --- bottom --- T.D. 4385'

Show depth and thickness of all water, oil and gas formations.

OIL, GAS OR WATER RECORDS

Casing Record

Formation	Content	From	To	Size	Put in	Pulled Out
Surface	Water	0'	1293'	8 5/8"	1284.33'	-0-

Describe in detail the manner in which the well was plugged, indicating where the mud
 fluid was placed and the method or methods used in introducing it into the hold. If cement
 or other plugs were used, state the character of same and depth placed, from feet
 to feet for each plug set. MIRU Hallib to 4 1/2" drill pipe and plug as
follows: spot 70 sx cement from 4285-4005'
Drill pipe to 1360' and spot 80 sx cement from 1360-1040'. Pull drill pipe to 1020' &
circ hole. COOH w/drill pipe. Plug rat hole w/10 sx. (Cmt 50-50 Poz w/4% gel, 3%
CaCl per sk)

NOTE: APPLICATION TO BE FILED TO COMPLETE WELL AS A SALT WATER DISPOSAL WELL IN THE
 CEDAR HILLS FORMATION.


(If additional description is necessary, use BACK of this sheet)

Name of Plugging Contractor Halliburton Services
Great Bend, Kansas 67530

STATE OF Kansas COUNTY OF Barton, ss.

C. D. Dohrer (employee of owner) or (owner or operator) of the
 above-described well, being first duly sworn on oath, says: That I have knowledge of the
 facts, statements, and matters herein contained and the log of the above-described well as
 filed and that the same are true and correct. So help me God.

(Signature) C. D. Dohrer Area Mgr.
Box 287, Great Bend, Kansas 67530
 (Address)

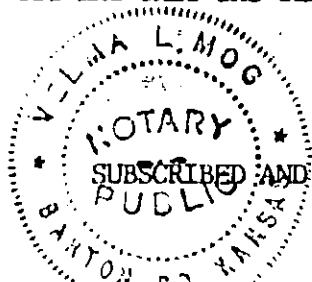

SWORN TO before me this 27th day of December, 1982

Velma L. Mog Notary Public.

My Commission expires: February 15, 1984

SIDE TWO

ACO-1 WELL HISTORY

OPERATOR Phillips Petroleum Co. LEASE Huling-AB Well #8

SEC. 15 TWP 21 RGE. 21W
Hodgeman County, Ks

FILL IN WELL LOG AS REQUIRED:

Show all important zones of porosity and contents thereof; cored intervals, and all drill-stem tests, including depth interval tested, cushion used, time tool open, flowing and shut-in pressures, and recoveries.

SHOW GEOLOGICAL MARKERS, LOGS RUN, OR OTHER DESCRIPTIVE INFORMATION.

FORMATION DESCRIPTION, CONTENTS, ETC.	TOP	BOTTOM	NAME	DEPTH
Surface	0'	1294'	Formation Top	0'
Shale	1294'	2130'	Heebner	3678'
Shells	2130'	2860'	Toronto	3698'
Shale and Lime	2860'	3510'	LKC	3732'
Lime	3510'	4085'	Marmaton	4070'
Lime and Shale	4085'	4385'	Ft. Scott	4252'
Total Depth	4385'		Cherokee	4282'
			Miss	4306'

RECEIVED
STATE COMMISSION

DEC 28 1982

CONSERVATION DIVISION
Wichita, Kansas