

STATE OF KANSAS  
STATE CORPORATION COMMISSION

WELL PLUGGING RECORD

Give All Information Completely  
Make Required Affidavit  
Mail or Deliver Report to  
Conservation Division  
State Corporation Comm.  
245 North Water  
Wichita, KS 67202

Hodgeman County. Sec. 23 Twp. 21S Rge. 21W E/W  
Location as "NE/CNW $\frac{1}{4}$ SW $\frac{1}{4}$ " or footage from lines  
N/2 N/2 NW

Lease Owner Galloway Drilling Co., Inc.  
Lease Name Five Star Well No. 2  
Office Address 340 Broadway Plaza Bldg, Wichita, KS  
Character of Well (Completed as Oil, Gas or Dry Hole)

Dry Hole


Date Well completed 6/11/82 19  
Application for plugging filed 6/11/82 19  
Application for plugging approved 6/11/82 19  
Plugging commenced 6/11/82 19  
Plugging completed 6/11/82 19

Reason for abandonment of well or producing formation  
dry hole

If a producing well is abandoned, date of last production  
none 19

Was permission obtained from the Conservation Division or  
its agents before plugging was commenced? Yes

Name of Conservation Agent who supervised plugging of this well Steve Durant  
Producing formation none Depth to top Bottom Total Depth of Well 4400  
Show depth and thickness of all water, oil and gas formations.

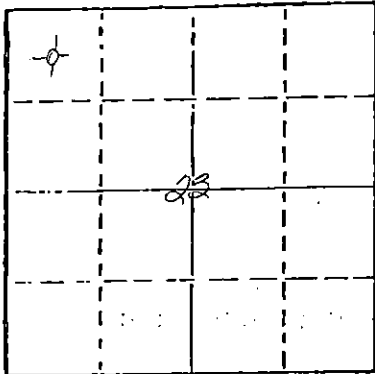

Locate well correctly on above  
Section Plat

OIL, GAS OR WATER RECORDS

CASING RECORD

FORMATION	CONTENT	FROM	TO	SIZE	PUT IN	PULLED OUT

Describe in detail the manner in which the well was plugged, indicating where the mud fluid  
was placed and the method or methods used in introducing it into the hold. If cement or other  
plugs were used, state the character of same and depth placed, from \_\_\_\_\_ feet to  
\_\_\_\_\_ feet for each plug set.

Set first plug at 1260' w/70sx common cement  
+4% Gel +3% CC. Second plug set @ 420' w/40sx  
cement +4% Gel +3% CC. Third plug set @ 40'  
w/10 sx cement +4% Gel +3% CC. Rat hole 10 sx.  
Plug down 6:30 p.m. 6/11/82

(If additional description is necessary, use BACK of this sheet)

Name of Plugging Contractor Galloway Drilling Co., Inc. and Allind Cementing

STATE OF KANSAS COUNTY OF SEDGWICK ss.  
Jay H. Galloway (employee of owner) or (owner or operator) of the above-described

well, being first duly sworn on oath, says: That I have knowledge of the facts, statements, and matters herein contained and the log of the  
above-described well as filed and that the same are true and correct. So help me God.

(Signature)

Jay H. Galloway, 340 Broadway Plaza Bldg  
Wichita, KS 67202

SUBSCRIBED AND SWORN TO before me this 11th day of June 1982

My commission expires Sept 9, 1985  
EARLENE M. LUMRY  
STATE NOTARY PUBLIC  
SEDGWICK COUNTY, KANSAS  
MY APPT. EXP. \_\_\_\_\_

Earlene M. Lumry Notary Public.

RECEIVED  
STATE CORPORATION COMMISSION

JUN 16 1982

CONSERVATION DIVISION  
Wichita Kansas

6-16-82