


STATE OF KANSAS
STATE CORPORATION COMMISSION

Form CP-4

Give All Information Completely
Make Required Affidavit
Mail or Deliver Report to:
Conservation Division
State Corporation Commission
P. O. Box 17027
Wichita, Kansas 67217
NORTH

WELL PLUGGING RECORD

Hodgeman County. Sec. 23 Twp. 21S Rge. (E) 21W (W)
Location as "NE/CNW/SW" or footage from lines C SW NE
Lease Owner Mack Oil Co.
Lease Name Eakin Well No. 1
Office Address 812 Union Center, Wichita, KS 67202
Character of Well (completed as Oil, Gas or Dry Hole) dry hole
Date well completed 11-22-72 19__
Application for plugging filed 11-27-72 19__
Application for plugging approved 11-27-72 19__
Plugging commenced 11-22-72 19__
Plugging completed 11-22-72 19__
Reason for abandonment of well or producing formation dry hole

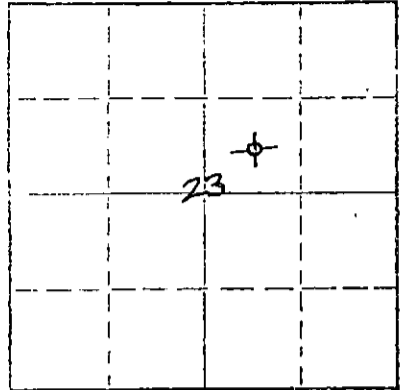

Locate well correctly on above Section Plat

If a producing well is abandoned, date of last production _____ 19__
Was permission obtained from the Conservation Division or its agents before plugging was commenced? yes

Name of Conservation Agent who supervised plugging of this well Edgar J. Eves, Sublette, KS
Producing formation _____ Depth to top _____ Bottom _____ Total Depth of Well 4380 Feet
Show depth and thickness of all water, oil and gas formations.

OIL, GAS OR WATER RECORDS

CASING RECORD

FORMATION	CONTENT	FROM	TO	SIZE	PUT IN	PULLED OUT
				8 5/8"	1186'	

Describe in detail the manner in which the well was plugged, indicating where the mud fluid was placed and the method or methods used in introducing it into the hole. If cement or other plugs were used, state the character of same and depth placed, from _____ feet to _____ feet for each plug set.

Plugged w/35 sx. cement @ 1000',
15 sx. cement @ 45'.

RECEIVED
STATE CORPORATION COMMISSION
NOV 28 1972
CONSERVATION DIVISION
Wichita, Kansas


Name of Plugging Contractor Thomas Drlg. Co., Inc.
Address P. O. Box 400, Duncan, OK 73533

STATE OF Kansas COUNTY OF Sedgwick, ss.
J. Corry Tinsmon (employee of owner) or (owner or operator) of the above-described

well, being first duly sworn on oath, says: That I have knowledge of the facts, statements, and matters herein contained and the log of the above-described well as filed and that the same are true and correct. So help me God.

(Signature) J. Corry Tinsmon
812 Union Center, Wichita, KS 67202
(Address)

Subscribed AND SWORN to before me this 27th day of November, 1972

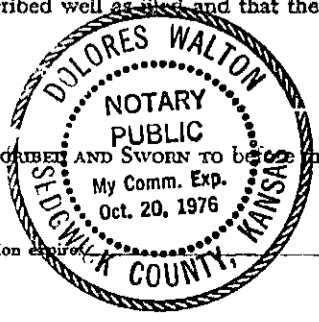

Dolores Walton
Notary Public.

My commission expires _____

MACK OIL COMPANY
Duncan, Oklahoma
73533

DRILLERS WELL LOG

#1 Eakin		C SW NE - Section 23-21S-21W
		Hodgeman County, Kansas
Commenced R.D.	11-12-72	Elevation: 2127' K.B., 2120' G.L.
Completed R.D.	11-22-72	Dry & Abandoned
Rotary Total Depth:	4380'	Contractor: Thomas Drlg. Co., Inc.

<u>STRATA</u>	<u>DEPTH</u>
Sand & Shale	0 - 395
Shale & Redbed	395 - 700
Sand	700 - 915
Sand & Redbed	915 - 1190
Redbed & Shale	1190 - 1272
Anhydrite	1272 - 1298
Shale & Shells	1298 - 1904
Shale & Lime	1904 - 2440
Lime	2440 - 3138
Lime & Shale	3138 - 3500
Lime	3500 - 4380 RTD

RECEIVED
STATE CORPORATION COMMISSION
NOV 28 1972
CONSERVATION DIVISION
Wichita, Kansas

I hereby certify that the above is a true and correct log of said well as reflected by the daily drilling reports.

MACK OIL CO.

By J. Corry Tinsmon
J. Corry Tinsmon

Signed and sworn to in my presence this 27th day of November, 1972, by J. Corry Tinsmon, representative of Mack Oil Company.....

Dolores Walton
Dolores Walton, Notary Public

