


STATE OF KANSAS
STATE CORPORATION COMMISSION

Give All Information Completely
Make Required Affidavit
Mail or Deliver Report to:
Conservation Division
State Corporation Commission
211 No. Broadway
Wichita, Kansas

WELL PLUGGING RECORD

Hodgeman County, Sec. 16 Twp. 21 Rge. (E) 21 (W)
Location as "NE/CNW/SW" or footage from lines C SE/4 SE/4
Lease Owner Colorado Oil & Gas Corporation
Lease Name Young "A" Well No. 2
Office Address P. O. Box 1030, Wichita, Kansas
Character of Well (completed as Oil, Gas or Dry Hole) Dry Hole
Date well completed August 27 1963
Application for plugging filed Verbal - August 27 1963
Application for plugging approved August 27 1963
Plugging commenced August 27 1963
Plugging completed August 27 1963
Reason for abandonment of well or producing formation _____

NORTH

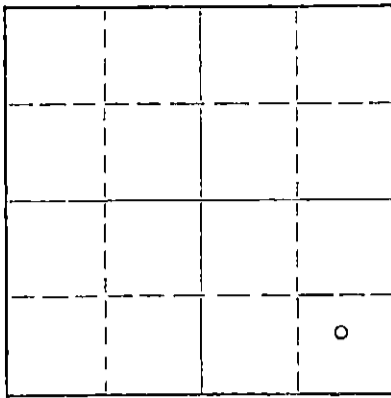

Locate well correctly on above
Section Plat

If a producing well is abandoned, date of last production _____ 19____
Was permission obtained from the Conservation Division or its agents before plugging was commenced? Yes

Name of Conservation Agent who supervised plugging of this well Hugh E. Scott
Producing formation _____ Depth to top _____ Bottom _____ Total Depth of Well 4339 Feet
Show depth and thickness of all water, oil and gas formations.

OIL, GAS OR WATER RECORDS

CASING RECORD

FORMATION	CONTENT	FROM	TO	SIZE	PUT IN	PULLED OUT
				8-5/8"	309'	None

Describe in detail the manner in which the well was plugged, indicating where the mud fluid was placed and the method or methods used in introducing it into the hole. If cement or other plugs were used, state the character of same and depth placed, from _____ feet to _____ feet for each plug set.

Rotary Mud to 510'
25 sacks cmt. @ 510'
Rotary Mud to 300'
25 sacks cmt. @ 300'
Rotary Mud to 40'
15 sacks cmt. @ 40' to cellar

RECEIVED
STATE CORPORATION COMMISSION

SEP 24 1963

CONSERVATION DIVISION
Wichita, Kansas

9-24-63

(If additional description is necessary, use BACK of this sheet)

Name of Plugging Contractor Murfin Drilling Company
Address 617 Union Center, Wichita, Kansas

STATE OF Kansas, COUNTY OF Sedgwick, ss.
Bill K. Henrichs (employee of owner) or (~~owner~~) of the above-described well, being first duly sworn on oath, says: That I have knowledge of the facts, statements, and matters herein contained and the log of the above-described well as filed and that the same are true and correct. So help me God.

(Signature) Bill K. Henrichs
P.O. Box 1030, Wichita, Kansas
(Address)

SUBSCRIBED AND SWORN to before me this 23rd day of September, 1963

My commission expires August 19, 1967

Helen L. Martin
Helen L. Martin Notary Public.



WELL LOG

COMPANY **Colorado Oil & Gas Corporation**

SEC. 16 T. 21 R. 21

FARM **YOUNG "A"** NO. **Two**

LOC. **C/SE SE**

RIG. NO. **12**


TOTAL DEPTH **4339'**

COUNTRY **Hodgeman KANSAS**

COMM. **8/15/63** COMP. **8/27/63**

SHOT OR TREATED **No**
CONTRACTOR **Murfin Drilling Company**

ISSUED

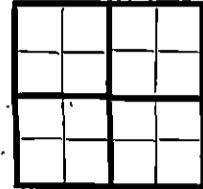

CASINO

20	.10
15	8 5/8" 309' with 250 sacks cement
12	6
13	5

ELEVATION

PRODUCTION **D & A**

FIGURES INDICATE BOTTOM OF FORMATIONS

- 70' Clay and Sand
- 150' Sand
- 735' Sand - Shale
- 950' Sand
- 1275' Shale - Red Bed
- 1300' Anhydrite
- 1710' Shale & Shells
- 2190' Shale & Lime
- 2235' Sand & Lime
- 2405' Lime
- 2480' Lime - Sandy Shale
- 2680' Lime
- 2720' Shale
- 3662' Lime - Shale
- 3666' Shale
- 3710' Lime-Shale
- 4319' Lime
- 4339' Mississippi
- 4339' Rotary Total Depth

RECEIVED
STATE CORPORATION COMMISSION

SEP 24 1963

CONSERVATION DIVISION
Wichita, Kansas

State of Kansas
County of Sedgwick } ss:

I, Fred Murfin of the Murfin Drilling Company

upon oath state that the above and foregoing is a true and correct copy of the log of the YOUNG "A" #2 well.

Subscribed and sworn to before me this 13th day of September 19 63

My Commission Expires: June 14, 1964

[Signature]
[Signature]
NOTARY PUBLIC