

STATE OF KANSAS  
STATE CORPORATION COMMISSION


Give All Information Completely  
Make Required Affidavit  
Mail or Deliver Report to:  
Conservation Division  
State Corporation Commission  
211 No. Broadway  
Wichita, Kansas

WELL PLUGGING RECORD

HODGEMAN County, Sec. 16 Twp. 21 Rge. 21 (E) W (W)

Location as "NE/CNW4SW4" or footage from lines NE - SE  
Lease Owner BEARDMORE DRILLING COMPANY  
Lease Name YOUNG "A" Well No. 1  
Office Address 700 ONE TWENTY BLDG WICHITA, KANSAS  
Character of Well (completed as Oil, Gas or Dry Hole) OIL  
Date well completed 8-18 1963  
Application for plugging filed 12-4 1967  
Application for plugging approved 12-4 1967  
Plugging commenced 12-6 1967  
Plugging completed 12-13 1967  
Reason for abandonment of well or producing formation DECLINING IN PRODUCTION

NORTH

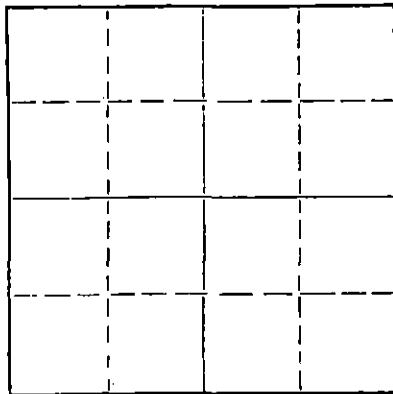

Locate well correctly on above  
Section Plat

If a producing well is abandoned, date of last production 12-1 1967  
Was permission obtained from the Conservation Division or its agents before plugging was commenced? YES

Name of Conservation Agent who supervised plugging of this well EDGAR EVES  
Producing formation MISSISSIPPI Depth to top 4,310' Bottom 4,315' Total Depth of Well 4,315' Feet  
Show depth and thickness of all water, oil and gas formations.

OIL, GAS OR WATER RECORDS

CASING RECORD

FORMATION	CONTENT	FROM	TO	SIZE	PUT IN	PULLED OUT
SAND & SHALE		0	185'			
SHALE & SHELLS		185'	260'	8-5/8"	260'	NONE

Describe in detail the manner in which the well was plugged, indicating where the mud fluid was placed and the method or methods used in introducing it into the hole. If cement or other plugs were used, state the character of same and depth placed, from \_\_\_\_\_ feet to \_\_\_\_\_ feet for each plug set.

0 TO 10' - 10 SACKS CEMENT (FILLED BOTTOM OF CELLAR)

10' TO 100' - 30 SACKS CEMENT - PUMPED BY HALLIBURTON

100' TO 550' - 7 SACKS JELLED HEAVY MUD

550' TO 900' - 100 SACKS CEMENT - PUMPED BY HALLIBURTON

900' TO 4,270' - MUD

(PULLED 3,276' OF 5-1/2" CASING)

4,270' TO 4,300' - 5 SACKS CEMENT

4,300' TO 4,315' - SAND

RECEIVED  
STATE CORPORATION COMMISSION  
JAN 19 1968  
CONSERVATION DIVISION  
Wichita, Kansas

(If additional description is necessary, use BACK of this sheet)  
Name of Plugging Contractor GLENN & SMITH PIPE PULLING COMPANY  
Address ELLINWOOD, KANSAS


STATE OF KANSAS, COUNTY OF SEDGWICK, ss.

Heber Beardmore (employee of owner) or (owner or operator) of the above-described well, being first duly sworn on oath, says: That I have knowledge of the facts, statements, and matters herein contained and the log of the above-described well as filed and that the same are true and correct. So help me, God.

(Signature) Heber Beardmore

700 120 BUILDING WICHITA, KANSAS  
(Address)

Subscribed and sworn to before me this 15 day of JANUARY, 1968

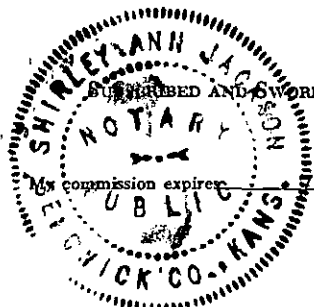

-13-71

Shirley Ann Jackson  
SHIRLEY ANN JACKSON  
Notary Public.

WELL LOG

COMPANY Colorado Oil & Gas Corporation

SEC. 16 T. 21 R. 21  
LOC. C/NE SE

FARM Young NO. "A" #1

RIG. NO.

TOTAL DEPTH 4315'

COUNTRY Hodgeman  
KANSAS

COMM. 8-5-63

COMP. 8-13-63

SHOT OR TREATED  
CONTRACTOR Murfin Drilling Company



ISSUED

CASING

20 10  
15 5 7/8" 260' w/200 sacks  
12 6  
13 5 1/2" 4310' w/125 sacks

ELEVATION

PRODUCTION Oil

FIGURES INDICATE BOTTOM OF FORMATIONS

- 90 Sand & Shale
- 185 Shale & Sand
- 260 Shale & Shells
- 740 Shale
- 940 Sand
- 1278 Red Bed
- 1315 Anhydrite
- 1530 Shale & Shells
- 2120 Shale & Lime
- 2228 Lime & Shale
- 2275 Sandy Lime & Shale
- 2315 Sand, Lime & Shale
- 2800 Lime & Shale
- 3050 Lime
- 3622 Lime & Shale
- 3626 Shale
- 3790 Lime & Shale
- 4315 Lime
- 4315 Rotary Total Depth

RECEIVED  
STATE CORPORATION

DEC 11 1963

CONSERVATION DIVISION  
Wichita, Kansas

State of Kansas  
County of Sedgwick ss:

I, Fred Murfin of the Murfin Drilling Company

upon oath state that the above and foregoing is a true and correct copy of the log of the Young "A" #1 well.

Fred Murfin  
Fred Murfin

Subscribed and sworn to before me this 16th day of August 1963

My Commission Expires: ADELA MIZENER, Notary Public  
My commission expires November 5, 1966

Adela Mizener  
NOTARY PUBLIC