


STATE OF KANSAS
STATE CORPORATION COMMISSION

Form CP-4

Give All Information Completely
Make Required Affidavit
Mail or Deliver Report to:
Conservation Division
State Corporation Commission
P. O. Box 17027
Wichita, Kansas 67217
NORTH

WELL PLUGGING RECORD

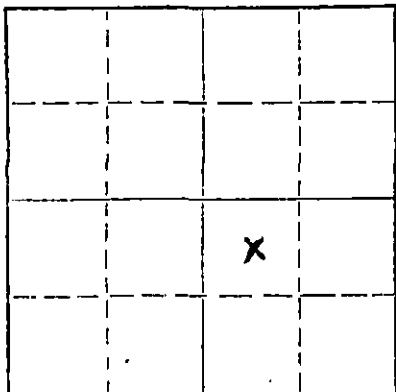

Locate well correctly on above
Section Plat

Hodgeman County, Sec. 8 Twp. 121 Rge. 22 (E) W (W)
Location as "NE/CNW/SW" or footage from lines C NW SE
Lease Owner Pickrell Drilling Co.
Lease Name Selfridge Well No. # 1
Office Address 705 Fourth Nat'l Bank Bldg., Wichita, Ks. 67202
Character of Well (completed as Oil, Gas or Dry Hole) Oil
Date well completed May 5 1960
Application for plugging filed July 31 1972
Application for plugging approved July 31 1972
Plugging commenced July 25 1972
Plugging completed August 21 1972
Reason for abandonment of well or producing formation Well Depleted

If a producing well is abandoned, date of last production May 17 1972
Was permission obtained from the Conservation Division or its agents before plugging was commenced? Yes

Name of Conservation Agent who supervised plugging of this well Edgar Eves
Producing formation Mississippian Depth to top 4339' Bottom 4351' Total Depth of Well 4351 Feet
Show depth and thickness of all water, oil and gas formations.

OIL, GAS OR WATER RECORDS

CASING RECORD

FORMATION	CONTENT	FROM	TO	SIZE	PUT IN	PULLED OUT
				8 5/8"	200	None
				5 1/2"	4339	386

Describe in detail the manner in which the well was plugged, indicating where the mud fluid was placed and the method or methods used in introducing it into the hole. If cement or other plugs were used, state the character of same and depth placed, from _____ feet to _____ feet for each plug set.

July 25, 1972 Plugged off bottom. Dumped sand to 3950'.
Mixed and dumped 5 sx of cement.
August 21, 1972 Plugged off top. Globe Oil Well Cementing Co.
mixed and pumped down 8 5/8" surface casing,
5 sx of gel, 30 sx of cement, 2 sx of gel, 30
sx of cement, 1 sx of gel and 15 sx of cement.

RECEIVED
STATE CORPORATION COMMISSION

SEP 11 1972

CONSERVATION DIVISION
Wichita, Kansas

9-14-72


(If additional description is necessary, use BACK of this sheet)
Name of Plugging Contractor RUSS CASING PULLING, INC.
Address P. O. Box 1082 ; Great Bend, Kansas 67530

STATE OF Kansas, COUNTY OF Sedgwick, ss.
Dale M. Robinson (employee of owner) or (owner or operator) of the above-described

well, being first duly sworn on oath, says: That I have knowledge of the facts, statements, and matters herein contained and the log of the above-described well as filed and that the same are true and correct. So help me God.

(Signature) Dale M. Robinson
705 Fourth National Bank Bldg., Wichita, Kansas
(Address)

Subscribed and Sworn to before me this 12th day of September, 19 72
January 19, 1973
Esther Lamone
Notary Public.

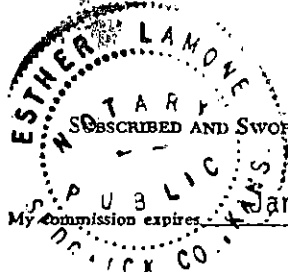

ROTARY DRILLING LOG

COMPANY: Pickrell Drilling Company
705 Fourth National Bank Building
Wichita 2, Kansas
LOCATION: Selfridge #1
NW SE, Sec. 8-21-22
Hodgeman County, Kansas
CONTRACTOR: PICKRELL DRILLING COMPANY
Wichita, Kansas

Rotary Drilling Commenced 4-11-60

Rotary Drilling Completed 4-24-60

CASING RECORD: 200' (5 jts.) 8-5/8" Armco Spiral Weld Casing set @ 200'
cemented with 175 sacks of cement. Cement circulated.
Completed at 12 midnight, 4-11-60.

Ran 141 jts. 5 1/2" O.D. Smls., J-55 Nat. Csg. Csg. set at
4334' and cemented with 100 sacks cement, 2% gel. Completed
@ 11:00 A.M., 4-24-60. LOG

(Figures indicate bottom of formation — measurements from top of rotary bushing.)

Table with 3 columns: Depth (60-4346), Formation (Top soil - rock-clay, Clay - gravel, Shale, etc.), and Circ. for Samples (4022', 4328', etc.). Includes Slope Tests and S.L.M. data.

RECEIVED
STATE CORPORATION COMMISSION
AUG 22 1972
CONSERVATION DIVISION
Wichita, Kansas

Partner

The undersigned, C. W. Sebitts, Attorney-in-Fact for PICKRELL DRILLING COMPANY, hereby certifies in behalf of said Company, that the above is a true and correct log of the formation encountered in drilling the above well as reflected by the Daily Drilling Reports.

PICKRELL DRILLING COMPANY

By [Signature]
C. W. Sebitts, Partner

STATE OF KANSAS
COUNTY OF SEDGWICK } ss.:

On this 2nd day of May, 1960, before me the undersigned, a Notary Public, in and for

the County and State aforesaid, personally appeared C. W. Sebitts, to me known to be the identical person who subscribed the name of PICKRELL DRILLING COMPANY to the foregoing instrument as its Attorney-in-Fact and acknowledged to me that he executed the same as his free and voluntary act and deed, and as the free and voluntary act and deed of such company, for the uses and purposes therein set forth.

Given under my hand and seal of office the day and year last above written.

My commission expires: August 13, 1961

[Signature]
Notary Public
Ruth M. Sullivan

File Copy