


STATE OF KANSAS
STATE CORPORATION COMMISSION

WELL PLUGGING RECORD

Give All Information Completely
Make Required Affidavit
Mail or Deliver Report to
Conservation Division
State Corporation Comm.
245 North Water
Wichita, KS 67202

Pawnee County, Sec. 8 Twp. 21S Rge. 20 ~~XX~~/W
Location as "NE/CNW $\frac{1}{2}$ SW $\frac{1}{2}$ " or footage from lines
C SW $\frac{1}{2}$

Lease Owner Benson Mineral Group, Inc.
Lease Name Steffen Well No. 2
Office Address 1536 Cole Blvd., Suite 220, Golden CO 80401
Character of Well (Completed as Oil, Gas or Dry Hole)

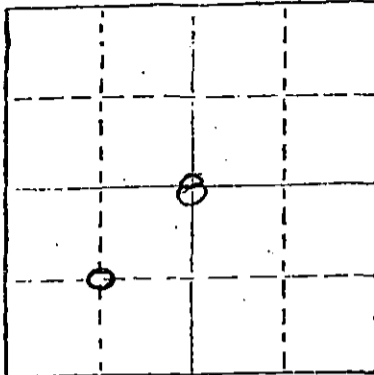

Locate well correctly on above Section Plat

Gas
Date Well completed 5-16 1982
Application for plugging filed 7-1 1983
Application for plugging approved 7-25 1983
Plugging commenced 8-9 1983
Plugging completed 8-9 1983
Reason for abandonment of well or producing formation
Junked hole

If a producing well is abandoned, date of last production
N.A. 19

Was permission obtained from the Conservation Division or its agents before plugging was commenced? Yes

Name of Conservation Agent who supervised plugging of this well J. H. Metz
Producing formation Krider Depth to top 2204 Bottom 2218 Total Depth of Well 2380
Show depth and thickness of all water, oil and gas formations.

OIL, GAS OR WATER RECORDS

CASING RECORD

FORMATION	CONTENT	FROM	TO	SIZE	PUT IN	PULLED OUT
Krider	Gas & water			7"	963'	0
				4 $\frac{1}{2}$ "	2380'	0

Describe in detail the manner in which the well was plugged, indicating where the mud fluid was placed and the method or methods used in introducing it into the hole. If cement or other plugs were used, state the character of same and depth placed, from _____ feet to _____ feet for each plug set.

1 sx hulls, 120 sx 60-40 POZ, 2% gel inside 4 $\frac{1}{2}$ " from 2204 to surface

RECEIVED
STATE CORPORATION COMMISSION

AUG 22 1983

CONSERVATION DIVISION
Wichita, Kansas

(If additional description is necessary, use BACK of this sheet)

Name of Plugging Contractor Sun Cementing 8-22-83

STATE OF COLORADO COUNTY OF JEFFERSON, ss.
Sue Johnson (employee of owner) or (owner or operator)
of the above-described well, being first duly sworn on oath, says: That I have knowledge of the facts, statements, and matters herein contained and the log of the above-described well as filed and that the same are true and correct. So help me God.

(Signature) Sue Johnson
1536 Cole Blvd., Suite 220, Golden CO 80401
(Address)

SUBSCRIBED AND SWORN TO before me this 18th day of August, 1983.

My commission expires July 25, 1986

Marilyn M. Markel
Notary Public.

Steffen #2

Plugging Procedure - No recoverable csg., as annulus between

7" & 4½" squeezed 150 sx 50-50 pos

7" @ 963 x 250 sk 60-40 Poz 3% C.C.

4½" @ 2380 x 250 sk 50-50 poz

Top cmt 1700' before squeeze

PBTD 2360' 1214' 2 3/8" in hole

Csg collapsed around 2 3/8" tbg @ 959' tbg shot off 956' could circ. around tbg before shot, but could not pull. Recommend no hulls in order to prevent bridge around tbg.

1. Pump 110 sx common 5% gel to 2360'.

RECEIVED
STATE CORPORATION COMMISSION

JUL 05 1983

CONSERVATION DIVISION
Wichita, Kansas