


Give All Information Completely  
Make Required Affidavit  
Mail or Deliver Report to:  
Conservation Division  
State Corporation Commission  
211 No. Broadway  
Wichita, Kansas

WELL PLUGGING RECORD

NORTH

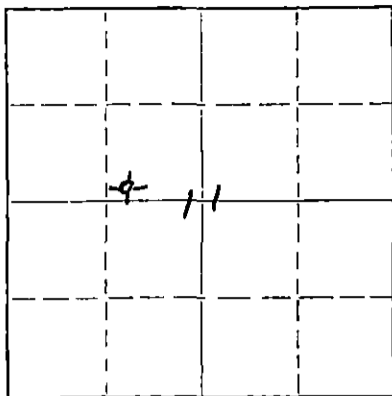

Locate well correctly on above Section Plat

Pawnee County, Sec. 11 Twp. 21 Rge. 20 (W)  
Location as "NE/CNWxSWx" or footage from lines SW-SE-NW  
Lease Owner D. R. Lauck Oil Co., Inc.  
Lease Name Bryant "B" Well No. 1  
Office Address 301 South Broadway, Wichita, Kansas  
Character of Well (completed as Oil, Gas or Dry Hole) Dry Hole  
Date well completed September 20 19 61  
Application for plugging filed April 16 19 62  
Application for plugging approved April 18 19 62  
Plugging commenced April 18 19 62  
Plugging completed April 25 19 62  
Reason for abandonment of well or producing formation Non productive

If a producing well is abandoned, date of last production 19  
Was permission obtained from the Conservation Division or its agents before plugging was commenced? Yes

Name of Conservation Agent who supervised plugging of this well Mr. W. L. Lackamp  
Producing formation Mississippi Depth to top 4347 Bottom 4460 Total Depth of Well 4515 Feet  
Show depth and thickness of all water, oil and gas formations. PB 4487

OIL, GAS OR WATER RECORDS

CASING RECORD

FORMATION	CONTENT	FROM	TO	SIZE	PUT IN	PULLED OUT
Lansing	Dry	3756	4086	8 5/8	215	None
Marmaton	Dry	4104	4254	5 1/2	4515	2748
Cherokee Shale	Dry	4254	4347			
Mississippi	Water	4347	4460			
Kinderhook	Dry	4460	4515			

Describe in detail the manner in which the well was plugged, indicating where the mud fluid was placed and the method or methods used in introducing it into the hole. If cement or other plugs were used, state the character of same and depth placed, from feet to feet for each plug set.

Set Plug 4260  
5 Sx. cement 4260-4230  
Mud 3970- 210  
Rock Bridge 210- 200  
20 Sx. cement 200- 140  
Mud 140- 40  
Rock and 10 Sx. cement 40-cellar base

RECEIVED  
STATE CORPORATION COMMISSION  
SEP 17 1962  
CONSERVATION DIVISION  
Wichita, Kansas

(If additional description is necessary, use BACK of this sheet)

Name of Plugging Contractor Glenn and Smith Pipe Pulling Co.  
Address P. O. Box 114, Ellinwood, Kansas

STATE OF Kansas, COUNTY OF Barton, ss.  
H. E. Wolfe (employee of owner) or (owner or operator) of the above-described well, being first duly sworn on oath, says: That I have knowledge of the facts, statements, and matters herein contained and the log of the above-described well as filed and that the same are true and correct. So help me God.

(Signature) *H. E. Wolfe*  
P. O. Box 488, Ellinwood, Kansas  
(Address)

SUBSCRIBED AND SWORN TO before me this 13th day of September, 19 62

My commission expires 8-21-65

Notary Public.

