


STATE OF KANSAS  
STATE CORPORATION COMMISSION

WELL PLUGGING RECORD

Give All Information Completely  
Make Required Affidavit  
Mail or Deliver Report to  
Conservation Division  
State Corporation Comm.  
245 North Water  
Wichita, KS 67202

Pawnee County, Sec. 11 Twp. 21S Rge. 20W E/W  
Location as "NE/CNW 1/4 SW 1/4" or footage from lines C SE/4  
Lease Owner Benson Mineral Group, Inc.  
Lease Name Lipp #1-11 QWVO Well No.   
Office Address 1726 Champa St, Suite 600, Denver, Colo. 80202  
Character of Well (Completed as Oil, Gas or Dry Hole) Washdown Abandoned  
Date Well completed December 15, 1980  
Application for plugging filed December 15, 1980  
Application for plugging approved December 15, 1980  
Plugging commenced 11:00 PM December 15, 1980  
Plugging completed 12:00 Midnight - December 15, 1980  
Reason for abandonment of well or producing formation Lost hole due to stuck pipe.  
If a producing well is abandoned, date of last production 19

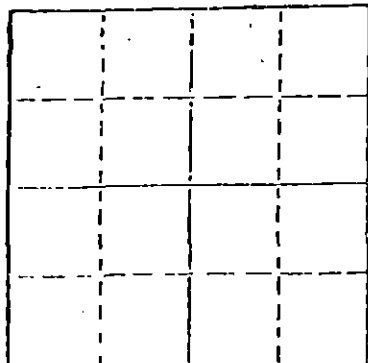

Locate well correctly on above  
Section Plat

Was permission obtained from the Conservation Division or  
its agents before plugging was commenced? Yes

Name of Conservation Agent who supervised plugging of this well Marion Schmidt  
Producing formation  Depth to top  Bottom  Total Depth of Well 2311'  
Show depth and thickness of all water, oil and gas formations.

OIL, GAS OR WATER RECORDS


CASING RECORD

FORMATION	CONTENT	FROM	TO	SIZE	PUT IN	PULLED OUT
		Surface	315'	7"		None
(PIPE SET WHEN ORIGINALLY DRILLED IN 1976)						

Describe in detail the manner in which the well was plugged, indicating where the mud fluid  
was placed and the method or methods used in introducing it into the hold. If cement or other  
plugs were used, state the character of same and depth placed, from  feet to  
 feet for each plug set.

Filled hole with heavy mud.  
Plugged with 70 sacks 60/40 Pozmix with 12-22-80  
2% cc and 2% gel at 660'; 25 sacks at  
240'; 10 sacks at 40'.

Shot off drill pipe at 651'. Left 42 joints 3 1/3" drill pipe  
and 10 4 3/4" drill collars in hole.

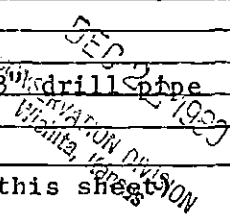

(If additional description is necessary, use BACK of this sheet)

Name of Plugging Contractor Sterling Drilling Company, P. O. Box 129, Sterling, Kansas 67579

STATE OF KANSAS COUNTY OF RICE, ss.  
F. A. Wuellner (employee of owner) or (owner or operator)

of the above-described well, being first duly sworn on oath, says: That I have knowledge of  
the facts, statements, and matters herein contained and the log of the above-described well  
as filed and that the same are true and correct. So help me God.

(Signature) F. A. Wuellner  
F. A. Wuellner, Secretary  
P. O. Box 129, Sterling, Kansas 67579  
(Address)

SUBSCRIBED AND SWORN TO before me this 17th day of December, 1980.



Charles M. Hall  
Charles M. Hall, Notary Public.

My commission expires

STERLING DRILLING COMPANY  
P. O. Box 129  
Sterling, Kansas 67579

WELL LOG - - - - - LIPP 1-11 OWWO  
Located: C SE/4, Section 11-21S-20W, Pawnee County, Kansas

OWNER: Benson Mineral Group, Inc.  
ROTARY DRILLING CONTRACTOR: Sterling Drilling Company

COMMENCED: December 8, 1980  
COMPLETED: December 15, 1980

TOTAL DEPTH: 2311'

LOG

CASING RECORD

0 - 2240 Washdown	Casing already set.
2240 - 2311 Lime and Shale	Lost hole due to stuck pipe. Shot off casing at 651'. Plugged.