


STATE OF KANSAS
STATE CORPORATION COMMISSION
CONSERVATION DIVISION
P. O. BOX 17027
WICHITA, KANSAS 67217

FORM CP-4

WELL PLUGGING RECORD

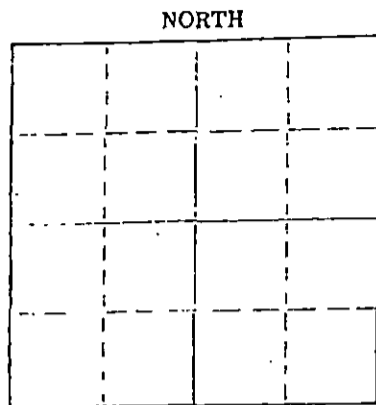

Locate well correctly on above Section Plat

Pawnee County. Sec. 11 Twp. 21 Rge. 20W (E) (W) XX
Location as "NE/CNW/SE/SW" or footage from lines: SE/4
Lease Owner BMG, INC.
Lease Name Lipp Well No. # 1
Office Address 1400 Metro Bank Building, Denver, CO 80202
Character of Well (completed as Oil, Gas or Dry Hole) Dry hole
Date well completed 8/5/76 1976
Application for plugging filed 8/5/76 1976
Application for plugging approved 8/5/76 1976
Plugging commenced 8/5/76 1976
Plugging completed 8/5/76 1976
Reason for abandonment of well or producing formation Dry hole
If a producing well is abandoned, date of last production _____ 19____
Was permission obtained from the Conservation Division or its agents before plugging was commenced? yes

Name of Conservation Agent who supervised plugging of this well Leo F. Massey
Producing formation _____ Depth to top _____ Bottom _____ Total Depth of Well 2240' Feet
Show depth and thickness of all water, oil and gas formations.

OIL, GAS OR WATER RECORDS

CASING RECORD

FORMATION	CONTENT	FROM	TO	SIZE	PUT IN	PULLED OUT

Describe in detail the manner in which the well was plugged, indicating where the mud fluid was placed and the method or methods used in introducing it into the hole. If cement or other plugs were used, state the character of same and depth placed, from _____ feet to _____ feet for each plug set.

Plugged hole with 100 sacks common, squeeze with plug

RECEIVED
STATE CORPORATION COMMISSION

SEP 01 1976

9-1-76

CONSERVATION DIVISION
Wichita, Kansas

(If additional description is necessary, use BACK of this sheet)

Name of Plugging Contractor BMG, INC.
Address Box 846, Independence, KS 67301

STATE OF KANSAS COUNTY OF MONTGOMERY ss.
Wm. T. Philo (employee of owner) or ~~(owner)~~ of the above-described

well, being first duly sworn on oath, says: That I have knowledge of the facts, statements, and matters herein contained and the log of the above-described well as filed and that the same are true and correct. So help me God.

(Signature) Wm. T. Philo
Box 846, Independence, Kansas 67301
(Address)

SUBSCRIBED AND SWORN TO before me this 18th day of August, 1976

My commission expires 5/7/80 Gail L. Tucker Notary Public.



KANSAS DRILLERS LOG

S. 11 T. 21 R. 20 $\frac{E}{W}$

API No. 15 — 145 — 20426-0000
County Number

Loc. SE/L

Operator


County Pawnee

BMG, INC.

640 Acres
N

Address

1100 Metro Bank Bldg., 17th St., Denver, Colorado 80202

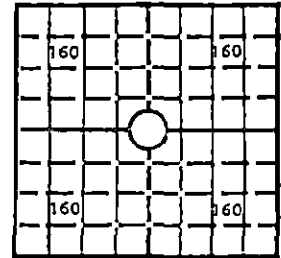

Well No.

Lease Name

1

Lipp

Footage Location

feet from (N) (S) line

feet from (E) (W) line

Principal Contractor

Geologist

B & N Drilling Company

Spud Date

Total Depth

P.B.T.D.

8/1/76

2240'

Date Completed

Oil Purchaser

8/5/76

Elev.: Gr. _____

DF _____ KB _____

CASING RECORD

Report of all strings set—surface, intermediate, production, etc.

Purpose of string	Size hole drilled	Size casing set (in O.D.)	Weight lbs/ft.	Setting depth	Type cement	Sacks	Type and percent additives
Surface	9"	7"		315'			
Production	6 $\frac{1}{2}$ "						

RECEIVED
 STATE CORPORATION COMMISSION
 SEP 01 1976
 CONSERVATION DIVISION
 Wichita, Kansas

LINER RECORD

PERFORATION RECORD

Top, ft.	Bottom, ft.	Sacks cement	Shots per ft.	Size & type	Depth interval

Size	Setting depth	Packer set at

ACID, FRACTURE, SHOT, CEMENT SQUEEZE RECORD

Amount and kind of material used	Depth interval treated

INITIAL PRODUCTION

Date of first production		Producing method (flowing, pumping, gas lift, etc.)			
RATE OF PRODUCTION PER 24 HOURS	Oil bbls.	Gas MCF	Water bbls.	Gas-oil ratio	CFPB
Disposition of gas (vented, used on lease or sold)			Producing interval (s)		

INSTRUCTIONS: As provided in KCC Rule 82-2-125, within 90 days after completion of a well, one completed copy of this Drillers Log shall be transmitted to the State Geological Survey of Kansas, 4150 Monroe Street, Wichita, Kansas 67209. Copies of this form are available from the Conservation Division, State Corporation Commission, 3830 So. Meridian (P.O. Box 17027), Wichita, Kansas 66217. Phone AC 316-522-2206. If confidential custody is desired, please note Rule 82-2-125. Drillers Logs will be on open file in the Oil and Gas Division, State Geological Survey of Kansas, Lawrence, Kansas 66044.

DESIGNATE TYPE OF COMP.: OIL, GAS, DRY HOLE, SWDW, ETC.:

Operator

BMG, INC.

15-145-20426-0000

Well No.

1

Lease Name

Lipp

S11 T21 R20 E W

WELL LOG

Show all important zones of porosity and contents thereof; cored intervals, and all drill-stem tests, including depth interval tested, cushion used, time tool open, flowing and shut-in pressures, and recoveries.

SHOW GEOLOGICAL MARKERS, LOGS RUN, OR OTHER DESCRIPTIVE INFORMATION.

FORMATION DESCRIPTION, CONTENTS, ETC.	TOP	BOTTOM	NAME	DEPTH
soil	0	5		
shale	5	134		
sand	134	168		
shale	168	254		
sand	254	260		
shale	260	274		
sand	274	318		
shale	318	485		
red clay	485	589		
Anhydrite	589	600		
shale	600	1100		
shale/lime	1100	1253		
Anhydrite	1253	1278		
shale	1278	1425		
lime	1425	1438		
shale/lime	1438	1485		
lime	1485	1488		
shale	1488	1512		
shale/lime	1512	1579		
shale	1579	1592		
shale/lime	1592	1608		
lime	1608	1611		
shale/lime	1611	1633		
lime/shale	1633	1649		
shale	1649	1652		
lime/shale	1652	1669		
shale	1669	1674		
lime/shale	1674	1686		
shale	1686	1716		
lime/shale	1716	1740		
shale	1740	1784		
lime/shale	1784	1814		
shale	1814	1839		
lime	1839	1840		
lime/shale	1840	1864		
lime	1864	1865		
shale	1865	1889		
lime	1889	1900		
lime/shale	1900	2020		
lime	2020	2030		

USE ADDITIONAL SHEETS, IF NECESSARY, TO COMPLETE WELL RECORD.

Date Received

Signature

Title

Date

lime/shale	2030	2119		
shale/lime	2119	2128		
lime/shale	2128	2162	lime	2162 2240