

STATE OF KANSAS  
STATE CORPORATION COMMISSION


WELL PLUGGING RECORD

OR  
FORMATION PLUGGING RECORD

Strike out upper line when reporting plugging of formations.

Give All Information Completely  
Make Required Affidavit  
Mail or Deliver Report to:  
Conservation Division  
State Corporation Commission  
800 Bittling Building  
Wichita, Kansas

NORTH

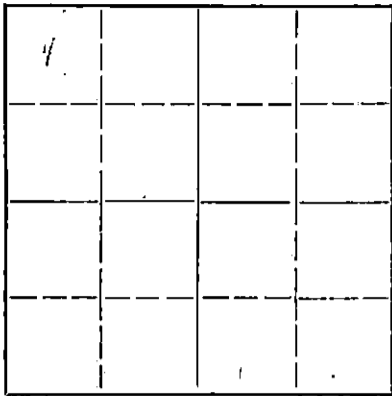

Locate well correctly on above Section Plat

Pawnee County, Sec. 20 Twp. 21S Rge. 20 (E) W. (W)  
Location as "NE 1/4 NW 1/4 SW 1/4" or footage from lines NE 1/4 NE 1/4 NE 1/4  
Lease Owner Continental Oil Company  
Lease Name J. C. Browne Well No. 1  
Office Address P. O. Box 1267, Ponca City, Oklahoma  
Character of Well (completed as Oil, Gas or Dry Hole) Dry Hole  
Date well completed May 4, 1944  
Application for plugging filed May 4, 1944  
Application for plugging approved May 4, 1944  
Plugging commenced May 4, 1944  
Plugging completed May 4, 1944  
Reason for abandonment of well or producing formation Dry Hole

If a producing well is abandoned, date of last production No production 19...  
Was permission obtained from the Conservation Division or its agents before plugging was commenced? Yes

Name of Conservation Agent who supervised plugging of this well Mr. Ruel E. Durkee, McPherson, Kansas  
Producing formation Arbuckle Lime Depth to top 4648' Bottom 4908' Total Depth of Well 4908 Feet  
Show depth and thickness of all water, oil and gas formations.

OIL, GAS OR WATER RECORDS

CASING RECORD

Formation	Content	From	To	Size	Put In	Pulled Out
				13" OD	236' 11"	None
				9.5/8" OD	1177' 2"	None

Describe in detail the manner in which the well was plugged, indicating where the mud fluid was placed and the method or methods used in introducing it into the hold. If cement or other plugs were used, state the character of same and depth placed, from... feet to... feet for each plug set.  
The hole was filled with heavy mud to within 250' of the top where a wood plug was set and cemented with 20 sacks of cement. The hole was then filled with heavy mud to within 20' of the top, where a second wood plug was set and capped with 10 sacks of cement.

PLUGGING  
FILE 15-26 21-200  
BOOK PAGE 116 LINE 33



(If additional description is necessary, use BACK of this sheet)  
Correspondence regarding this well should be addressed to Continental Oil Company  
Address R. F. D. #4, Lyons, Kansas

STATE OF Kansas, COUNTY OF Rice, ss.  
F. L. Dunn (employee of owner) or (owner or operator) of the above-described well,  
being first duly sworn on oath, says: That I have knowledge of the facts, statements, and matters herein contained and the log of the above-described well as filed and that the same are true and correct. So help me God.

(Signature) F. L. Dunn

R. F. D. #4, Lyons, Kansas (Address)

SUBSCRIBED AND SWORN TO before me this 27th day of May 1944

Louis Mc Guire Notary Public

My commission expires October 21st, 1944

W E L L R E C O R D

J. C. Browne Well No. 1

Date Spudded: 3-17-44	Loc: 330' South and 330' West of NE
Drig. Completed: 5-4-44	corner of Sec. 20, Twp. 21S, Rge. 20W,
Date Plugged: 5-4-44	Pawnee County, Kansas

FROM	TO	FORMATION	FROM	TO	FORMATION
0	10	Surface Clay	2130	2212	Broken Lime
10	40	Sand & Shale	2212	2230	Shale
40	90	Gravel	2230	2373	Anhydrite
90	120	Shale	2373	2460	Lime
120	210	Hard Sand	2460	3052	Broken Lime
210	230	Shale	3052	3329	Shale & Shells
230	235	Lime	3329	3335	Shale
235	560	Shale	3335	3388	Lime
560	575	Lime	3388	3451	Broken Lime
575	650	Shale	3451	3847	Lime
650	980	Sand	3847	3863	Lime (Hard)
980	1037	Shale	3863	4178	Lime
1037	1125	Red Bed	4178	4221	Broken Lime & Shale
1125	1170	Shale	4221	4260	Lime
1170	1235	Anhydrite	4260	4268	Shale
1235	1260	Lime	4268	4291	Chat
1260	1426	Shale	4291	4320	Chert
1426	1823	Shale & Shells	4320	4329	Chat
1823	1980	Shale	4329	4512	Lime
1980	2000	Lime	4512	4521	Sandy Lime
2000	2008	Shale	4521	4913	Lime
2008	2130	Shale & Shells			

Elevation 2103'

Ran 236'11" of 13" OD 50# ST Lapweld casing; set at 530'; cemented with 150 sacks of cement.

Ran 1177'2" of 9 5/8" OD 43# ST Grade "J-55" Seamless casing; set at 1168'; cemented with 500 sacks of cement.

Top of Kansas City Lime 3701' - no show of oil.

Top of Arbuckle Lime 4648 - no show of oil.

Drilled to a total depth of 4908' in Arbuckle Lime.

Plugged and abandoned May 4, 1944.

Note: All above footages calculated from ground level, except formations.

I, the undersigned, being first duly sworn upon oath, state that this well record is true, correct and complete, according to the records of this office, and to the best of my knowledge and belief.

J. L. Dunn District Superintendent

Subscribed and sworn to before me this 27th day of May, 1944.

Ky Commission expires October 21st, 1944.

Louis M. Guine  
Notary Public

DM-FMC  
-27-44  
PC (3)  
Corp. Comm.  
file

PLUGGING  
FILE NO. 2021-200  
BOOK PAGE 116 LINE 33

STATE OF KANSAS  
NOTARY PUBLIC  
L. M. GUINE