


STATE OF KANSAS
STATE CORPORATION COMMISSION

WELL PLUGGING RECORD

Give All Information Completely
Make Required Affidavit
Mail or Deliver Report to
Conservation Division
State Corporation Comm.
245 North Water
Wichita, KS 67202

Pawnee County. Sec. 18 Twp 21S Rge. 20W ~~XXX~~
Location as "NE/CNW $\frac{1}{4}$ SW $\frac{1}{4}$ " or footage from lines _____
C NW NW

Lease Owner Hummon Oil Company
Lease Name Cooper Well No. 1
Office Address 1725 Vickers-KSB&T Bldg., Wichita, Ks.
Character of Well (Completed as Oil, Gas or Dry Hole) _____
Dry Hole

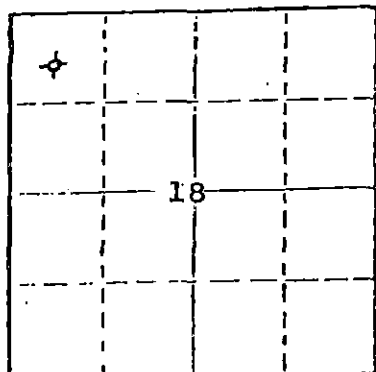

Locate well correctly on above
Section Plat

Date Well completed September 10, 1978
Application for plugging filed September 10, 1978
Application for plugging approved September 10, 1978
Plugging commenced September 10, 1978
Plugging completed September 10, 1978
Reason for abandonment of well or producing formation _____
Dry Hole

If a producing well is abandoned, date of last production _____
19__

Was permission obtained from the Conservation Division or
its agents before plugging was commenced? Yes

Name of Conservation Agent who supervised plugging of this well Leo F. Massey
Producing formation _____ Depth to top _____ Bottom _____ Total Depth of Well 3725'
Show depth and thickness of all water, oil and gas formations.

OIL, GAS OR WATER RECORDS

CASING RECORD

FORMATION	CONTENT	FROM	TO	SIZE	PUT IN	PULLED OUT
		0'	413'	8-5/8"	406.29'	None

Describe in detail the manner in which the well was plugged, indicating where the mud fluid
was placed and the method or methods used in introducing it into the hold. If cement or other
plugs were used, state the character of same and depth placed, from _____ feet to
_____ feet for each plug set.

Plugged with 102 sacks 50-50 Pozmix cement,
2% Gel (70 sacks at 720', 20 sacks at 390',
10 sacks at 40', 2 sacks in rat hole).

(If additional description is necessary, use BACK of this sheet)

Name of Plugging Contractor Allied Cementing Co.

STATE OF KANSAS COUNTY OF SEDGWICK, ss.
John D. Knightley Agent (employee of owner) or (owner or operator)
of the above-described well, being first duly sworn on oath, says: That I have knowledge of
the facts, statements, and matters herein contained and the log of the above-described well
as filed and that the same are true and correct. So help me God.

(Signature) [Signature]
221 S. Broadway, Wichita, Kansas
(Address)

SUBSCRIBED AND SWORN TO before me this 19th day of September, 1978

[Signature]
Notary Public.

My commission expires March 12, 1979

RECEIVED
STATE CORPORATION COMMISSION

SEP 20 1978

CONSERVATION DIVISION
Wichita, Kansas

Hummon Oil Company - Cooper #1
 C NW NW Sec. 18-21S-20W
 Pawnee County, Kansas

Contractor: D. R. Lauck Oil Company, Inc.
 221 S. Broadway, Suite 400
 Wichita, Kansas 67202

Commenced: September 4, 1978
 Completed: September 10, 1978

Drillers Log

Shale	60
Red Bed	1288
Anhydrite	1301
Shale	1455
Shale & Shells	2675
Shale & Lime	3450
Lime	3655
Lime & Shale	3725 RTD

RECEIVED
 STATE CORPORATION COMMISSION

SEP 20 1978

CONSERVATION DIVISION
 Wichita, Kansas