


STATE OF KANSAS
STATE CORPORATION COMMISSION

WELL PLUGGING RECORD

Give All Information Completely
Make Required Affidavit
Mail or Deliver Report to
Conservation Division
State Corporation Comm.
245 North Water
Wichita, KS 67202

Hodgeman County, Sec. 8 Twp. 21S Rge. 21W E/W
Location as "NE/CNW 1/4 SW 1/4" or footage from lines
C SW NW
Lease Owner W.E. Carl & Associated Petroleum Consultants, Inc.
Lease Name Lewis Well No. #3-8
Office Address Suite 600 - One Main Place, Wichita, KS
Character of Well (Completed as Oil, Gas or Dry Hole)
dry hole
Date Well completed January 14, 19 82
Application for plugging filed January 14, 19 82
Application for plugging approved January 14, 19 82
Plugging commenced 10:00 a.m. 19
Plugging completed 12:00 p.m. 19
Reason for abandonment of well or producing formation
D & A
If a producing well is abandoned, date of last production
None 19

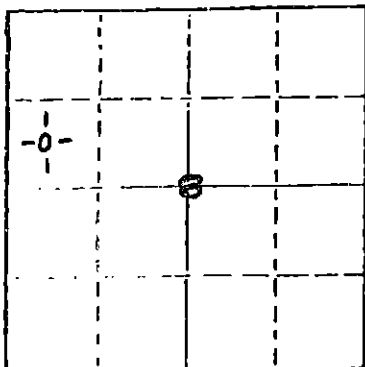

Locate well correctly on above
Section Plat

Name of Conservation Agent who supervised plugging of this well Steve Durrant
Producing formation X Depth to top X Bottom X Total Depth of Well 4420'
Show depth and thickness of all water, oil and gas formations.

OIL, GAS OR WATER RECORDS

CASING RECORD

FORMATION	CONTENT	FROM	TO	SIZE	PUT IN	PULLED OUT
				8 5/8"	657'	none

Describe in detail the manner in which the well was plugged, indicating where the mud fluid was placed and the method or methods used in introducing it into the hold. If cement or other plugs were used, state the character of same and depth placed, from _____ feet to _____ feet for each plug set.

Ran 1st plug @ 900' with 70 sacks 50/50 pozmix w/4% gel 3% CaCl
2nd plug @ 630' with 40 sacks
3rd plug @ 40' - Wooden Bridge Plug and Hulls - 10 sacks
Rat Hole 10 sacks
Mouse Hole 10 sacks

1-22-82

RECEIVED

STATE CORPORATION COMMISSION

(If additional description is necessary, use BACK of this sheet)

Name of Plugging Contractor Heartland Drilling, Inc.

JAN 22, 1982

CONSERVATION DIVISION

Wichita, Kansas
ss.

STATE OF KANSAS COUNTY OF SEDGWICK
Ray Williams (employee of owner) or (owner or operator)
of the above-described well, being first duly sworn on oath, says: That I have knowledge of the facts, statements, and matters herein contained and the log of the above-described well as filed and that the same are true and correct. So help me God.

(Signature)

Ray Williams
RAY WILLIAMS

(Address)

SUBSCRIBED AND SWORN TO before me this 18th day of January, 19 82

My commission expires

PHYLLIS BUCHANAN
NOTARY PUBLIC
STATE OF KANSAS
My Appt. Expires Jan. 2, 1984

Phyllis Buchanan
PHYLLIS BUCHANAN
Notary Public.