


STATE OF KANSAS
STATE CORPORATION COMMISSION

WELL PLUGGING RECORD

Give All Information Completely
Make Required Affidavit
Mail or Deliver Report to:
Conservation Division
State Corporation Commission
211 No. Broadway
Wichita, Kansas

Pawnee County. Sec. 22 Twp. 21 Rge. 17 ~~XXXX~~ (W)
Location as "NE/CNW/SW" or footage from lines NW NW NW
Lease Owner D. R. Lauck Oil Company, Inc.
Lease Name Nelson Well No. 1
Office Address 301 South Broadway Wichita Kansas
Character of Well (completed as Oil, Gas or Dry Hole) dry hole
Date well completed September 24 19 57
Application for plugging filed September 24 19 57
Application for plugging approved September 24 19 57
Plugging commenced September 24 19 57
Plugging completed September 24 19 57
Reason for abandonment of well or producing formation dry hole

NORTH

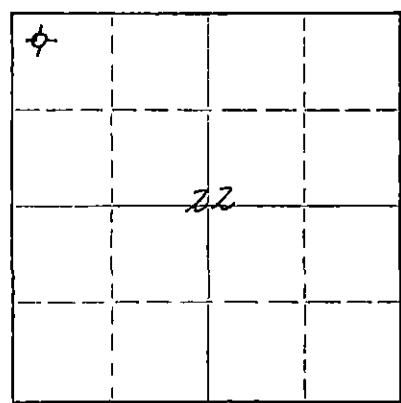

Locate well correctly on above
Section Plat

If a producing well is abandoned, date of last production -- 19 --
Was permission obtained from the Conservation Division or its agents before plugging was commenced? yes

Name of Conservation Agent who supervised plugging of this well R. M. Brundedge
Producing formation -- Depth to top -- Bottom -- Total Depth of Well 4000 Feet
Show depth and thickness of all water, oil and gas formations.

OIL, GAS OR WATER RECORDS

CASING RECORD

FORMATION	CONTENT	FROM	TO	SIZE	PUT IN	PULLED OUT
		1092	6'	8 5/8"	1092	none

Describe in detail the manner in which the well was plugged, indicating where the mud fluid was placed and the method or methods used in introducing it into the hole. If cement or other plugs were used, state the character of same and depth placed, from feet to feet for each plug set.

hole filled with mud	4,000 -	435
plug	435 -	431
1/3 sack hulls & 20 sks Cement & mud	431 -	35
plug	35 -	31
1/2 sack hulls & 10 sx cement	31 -	6 bottom of cellar

(If additional description is necessary, use BACK of this sheet)

Name of Plugging Contractor Globe Cementing Company
Address Great Bend Kansas

STATE OF Kansas, COUNTY OF Sedgwick, ss.
John H. Knightley (employee of owner) or (~~owner or operator~~) of the above-described well, being first duly sworn on oath, says: That I have knowledge of the facts, statements, and matters herein contained and the log of the above-described well as filed and that the same are true and correct. So help me God.
(Signature) John H. Knightley
Wichita Kansas (Address)

SUBSCRIBED AND SWORN TO before me this 1st day of October, 19 57
My commission expires Sept. 14, 1959
Elizabeth Gay Notary Public.

10-2-57

0912-155
CONSERVATION DIVISION
Wichita, Kansas

PLUGGING
FILE SEC. 22 T. 21 R. 17
BOOK PAGE 48 LINE 34

15-145-00269-0000

D. R. Lauck Oil Company, Inc.

#1 Nelson

NW NW NW Sec.22-21S-17W
Pawnee County Kansas

Commenced: September 12, 1957
Completed: September 24, 1957

Casing Record: 1,092 ft. 8 5/8" cem.w/500 sacks

Elevation: GR 2076; DF 2078; KB 2080

Drillers Log

Tops

			<u>Sample</u>
clay & shale	200		
shale	540		
sand	600	Heebner	3472-1392
shale & Red Bed	790	Toronto	3491-1411
red bed	1090	Douglas	3499-1419
Anhydrite	1125	Brown Lime	3556-1476
shale & shalls	1850	Lansing	3567-1487
Lime (Sandy)	1955	Conglomerate	3915-1835
lime	2570	Arbuckle	3949-1869
shale & lime	3350	Rotary Total Depth	4000-1920
lime	3445		
lime & shale	3529	D & A	
Douglas Shale	3558		
Brown Lime	3567		
Lansing	3588		
Lime	3945		
Conglomerate (cherty)	3949		
Arbuckle Lime	4000	RTD	

RECEIVED
STATE CORPORATION

OCT 2 - 1957

CONSERVATION DIV.
Wichita, Kansas

PLUGGING	
FILE SEC.	22-21-17W
BOOK PAGE	48 LINE 34