


STATE OF KANSAS  
STATE CORPORATION COMMISSION

WELL PLUGGING RECORD

Give All Information Completely  
Make Required Affidavit  
Mail or Deliver Report to  
Conservation Division  
State Corporation Comm.  
245 North Water  
Wichita, KS 67202

Pawnee County, Sec. 29 Twp. 21 Sge. 17 E/W  
Location as "NE/CNW $\frac{1}{2}$ SW $\frac{1}{2}$ " or footage from lines  
C of SW

Lease Owner Beren Corporation  
Lease Name Marlyn #1 Well No. \_\_\_\_\_  
Office Address Wichita, Kansas 67202  
Character of Well (Completed as Oil, Gas or Dry Hole) \_\_\_\_\_

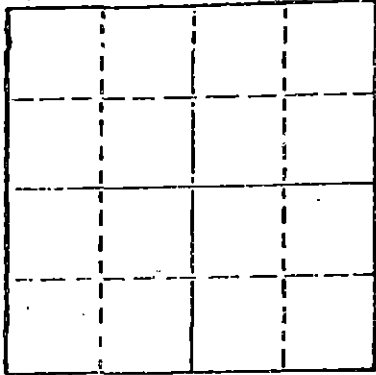

Locate well correctly on above  
Section Plat

Date Well completed \_\_\_\_\_ 19\_\_\_\_  
Application for plugging filed \_\_\_\_\_ 19\_\_\_\_  
Application for plugging approved \_\_\_\_\_ 19\_\_\_\_  
Plugging commenced 5/17/77 \_\_\_\_\_ 19\_\_\_\_  
Plugging completed 5/19/77 \_\_\_\_\_ 19\_\_\_\_  
Reason for abandonment of well or producing formation  
depleted.

If a producing well is abandoned, date of last production  
\_\_\_\_\_ 19\_\_\_\_

Was permission obtained from the Conservation Division or  
its agents before plugging was commenced? yes

Name of Conservation Agent who supervised plugging of this well Massey  
Producing formation \_\_\_\_\_ Depth to top \_\_\_\_\_ Bottom \_\_\_\_\_ Total Depth of Well 2020'  
Show depth and thickness of all water, oil and gas formations.

OIL, GAS OR WATER RECORDS

CASING RECORD

CONTENT	FROM	TO	SIZE	PUT IN	PULLED OUT
			7"	726	none
			4 1/2"	2013	1422'

RECEIVED  
STATE CORPORATION COMMISSION  
MAY 24 1977

Describe in detail the manner in which the well was plugged, indicating where the mud fluid  
was placed and the method or methods used in introducing it into the hold. If cement or other  
plugs were used, state the character of same and depth placed, from \_\_\_\_\_ feet to  
\_\_\_\_\_ feet for each plug set.

Sanded to 2000' and ran 4 sacks cement. Shot pipe at 1420', pulled 44 joints.  
Squeezed hole with 15 sacks gel, released plug and displaced with 75 sacks cement,  
60-40 pozmix.

PLUGGING COMPLETE.

(If additional description is necessary, use BACK of this sheet)

Name of Plugging Contractor KELSO CASING PULLING  
CHASE, KANSAS

STATE OF KANSAS COUNTY OF RICE, ss.

R. DARRELL KELSO (employee of owner) or (owner or operator) of the above-described  
well, being first duly sworn on oath, says: That I have knowledge of the facts, statements, and matters herein contained and the log of the  
above-described well as filed and that the same are true and correct. So help me God.

(Signature) [Signature]  
CHASE, KANSAS  
(Address)

Subscribed and sworn to before me this 23rd day of May, 19 77

My commission expires \_\_\_\_\_



[Signature]  
Notary Public.

STERLING DRILLING COMPANY  
P. O. Box 129  
Sterling, Kansas 67579

WELL LOG ----- MARLYN #1  
Located: C SW, Section 29-21S-17W, Pawnee County, Kansas

OWNER: Beren Corporation  
ROTARY DRILLING CONTRACTOR: Sterling Drilling Company

COMMENCED: October 7, 1973  
COMPLETED: October 11, 1973

TOTAL DEPTH: 2014'

<u>LOG</u>		<u>CASING RECORD</u>
0 - 86	Clay and Shale	Ran 24 joints 7", 20# casing, 725' pipe set at 726.50' G.L. Cemented with 175 sacks 60/40 Pozmix with 4% gel, 3% cc, followed with 75 sacks 60/40 Pozmix with 2% gel, 3% cc. Plug down at 11:45 AM, 10-8-73.
86 - 735	Shale and Sand	
735 - 1041	Shale	
1041 - 1063	Anhydrite	
1063 - 1300	Shale	
1300 - 2014	Lime and Shale	Ran 63 joints 4 1/2", 9.5# used seamless casing, 2027' pipe set at 2013' G.L. Cemented with 125 sacks 60/40 Pozmix, 18% salt saturated. Plug down at 10:45 AM, 10-11-73.

RECEIVED  
STATE CORPORATION COMMISSION

JAN 13 1977

CONSERVATION DIVISION  
Topeka, Kansas