

Give All Information Completely
Make Required Affidavit
Mail or Deliver Report to:
Conservation Division
State Corporation Commission
800 Bitting Building
Wichita, Kansas

WELL PLUGGING RECORD

OR

FORMATION PLUGGING RECORD

Strike out upper line when reporting plugging off formations.

NORTH

			0

**Locate well correctly on above
Section Plat**

800 Bitting Building
Wichita, Kansas

NORTH

			0

Locate well correctly on above
Section Plat

Pawnee

County. Sec. 26 Twp. 21 Rge. (E) 17 (W)

Location as "NE¼NW¼SW¼" or footage from lines. 330 ft. from E Line 330 from N L

Lease Owner. Helmerich & Payne, Inc.

Lease Name. Wilson Well No. 1

Office Address. Tulsa, Okla. 415 Philtower Bldg.

Character of Well (completed as Oil, Gas or Dry Hole) Dry hole

Date well completed Sept. 30 19 41

Application for plugging filed Sept. 30 19 41

Application for plugging approved Sept. 30 19 41

Plugging commenced Sept. 30 19 41

Plugging completed October 1 19 41

Reason for abandonment of well or producing formation Dry hole

If a producing well is abandoned, date of last production 19

Was permission obtained from the Conservation Division or its agents before plugging was commenced? Yes

Name of Conservation Agent who supervised plugging of this well C. T. Alexander

Producing formation Depth to top Bottom Total Depth of Well 4006 Feet

Show depth and thickness of all water, oil and gas formations.

OIL, GAS OR WATER RECORDS

CASING RECORD

[illegible]

Describe in detail the manner in which the well was plugged, indicating where the mud fluid was placed and the method or methods used in introducing it into the hole. If cement or other plugs were used, state the character of same and depth placed, from 760 feet to 740 feet for each plug set.

Filled hole with heavy mud to 760 feet - wood plug placed at 760 ft. with Burlap sack on same - 1/2 yard rock placed on plug - cemented with 15 sacks cement mixed and pumped in through drill pipe with William's cement company. Hole filled with heavy mud to 38 ft. Hole bridged - mixed and pumped in 5 sacks cement.

pd.

10/7/41

26 21 03W
BOOK AGE 10-LINE 15

10-8-41

(If additional description is necessary, use BACK of this sheet)

Correspondence regarding this well should be addressed to Helmerich & Payne, Inc.
Address 415 Philtower Bldg. Tulsa, Oklahoma.

STATE OF Oklahoma, COUNTY OF Tulsa, ss.
I, C. M. Copeland (employee of owner) or (owner of

being first duly sworn on oath, says: That I have knowledge of the facts, statements, and matters herein contained; and the log of the above-described well as filed and that the same are true and correct. So help me God.

(Signature)

415 Philtower Bldg., Tulsa, Okla.
(Address)

SUBSCRIBED AND SWORN to before me this 6th day of October, 1941

My commission expires

July 22, 1943



Wilson #1
NW 1/4 Sec 26 of Section 26-21S-17W
Pawnee County, Kansas
Superior Oil Corporation

15.145.00421-0000

Commenced: 9-15-41
 Completed: 10-1-41

Surface clay and shale	0	810
Red rock and shale	810	903
Shale and shells	903	1073
Anhydrite	1073	1088
Shale and shells	1088	1405
Red rock	1405	1500
Shale and salt	1500	1650
Sand	1650	1695
Shale and lime	1695	1925
Lime	1925	2190
Broken lime	2190	2275
Lime	2275	2496
Chert	2496	2498
Broken lime	2498	2515
Lime	2515	2550
Shale and lime	2550	3015
Lime	3015	3290
Shale	3290	3441
Lime	3441	3800
Lime and shale	3800	3928
Red and green shale & conglomerate	3928	3977
Conglomerate	3977	4028
Lime (silicious)	4028	4032
Arbuckle Lime		
TOTAL DEPTH		

CASING RECORD

Casing

8-5/8" Cemented at 760' with 300 sacks of cement.


PLUGGING RECORD

Ran cement and chat plug from 760' back to 740'. Filled with mud to 40' of surface pipe. Ran cement plug to 8' of surface.

STATE OF OKLAHOMA)

COUNTY OF TULSA)

I hereby affirm that the above and foregoing is a true and correct copy of the log of your Wilson Well #1, located in the Northeast Quarter of the Northeast Quarter of the Southeast Quarter of Section 26, Township 21 South, Range 17 West, Pawnee County, Kansas.

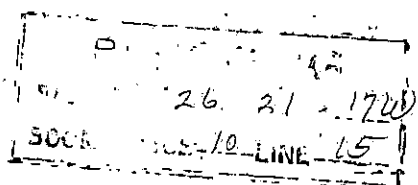

HELMERICH & PAYNE, INC.

BY William Z. Payne
 Treasurer

Subscribed and sworn to before me, a Notary Public, this 8th. day of October, 1941.

My commission expires July 22, 1943.

Notary Public

