


STATE OF KANSAS
STATE CORPORATION COMMISSION

Give All Information Completely
Make Required Affidavit
Mail or Deliver Report to:
Conservation Division
State Corporation Commission
800 Bitting Building
Wichita, Kansas

WELL PLUGGING RECORD

NORTH

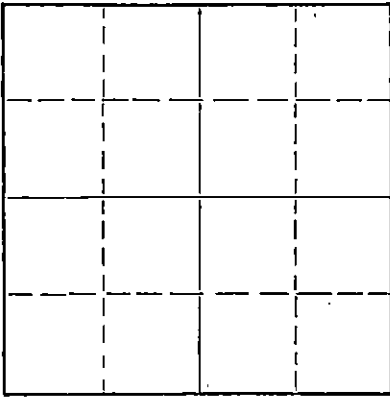

Locate well correctly on above
Section Plat

Pawnee County. Sec. 10 Twp. 21S Rge. 18 (E) (W)
Location as "NE/CNW/SW" or footage from lines NW NW SE
Lease Owner Fred B. Anschutz
Lease Name Browne Well No. 1
Office Address 709 Union Nat'l Bank Bldg.
Character of Well (completed as Oil, Gas or Dry Hole) Dry Hole
Date well completed April 10 1956
Application for plugging filed April 10 1956
Application for plugging approved April 10 1956
Plugging commenced April 11 1956
Plugging completed April 11 1956
Reason for abandonment of well or producing formation Dry hole

If a producing well is abandoned, date of last production _____ 19____
Was permission obtained from the Conservation Division or its agents before plugging was commenced? Yes

Name of Conservation Agent who supervised plugging of this well Mr. Brundage
Producing formation _____ Depth to top _____ Bottom _____ Total Depth of Well _____ Feet
Show depth and thickness of all water, oil and gas formations.

OIL, GAS OR WATER RECORDS

CASING RECORD

FORMATION	CONTENT	FROM	TO	SIZE	PUT IN	PULLED OUT
				8-5/8"	227'	

Describe in detail the manner in which the well was plugged, indicating where the mud fluid was placed and the method or methods used in introducing it into the hole. If cement or other plugs were used, state the character of same and depth placed, from _____ feet to _____ feet for each plug set.

hull
Filled hole with heavy mud to 300'. Put in/sack plus hulls to 235'. Set Halliburton Plug at 234' with 25 sacks cement. Set top plug at 30' with 10 sacks cement

(If additional description is necessary, use BACK of this sheet)

Name of Plugging Contractor Kan-Tex Const. Co., Inc.
Address Beacon Building, Wichita, Kansas


STATE OF Kansas, COUNTY OF Sedgwick, ss.
Lee Mankin (employee of owner) or (owner or operator) of the above-described well, being first duly sworn on oath, says: That I have knowledge of the facts, statements, and matters herein contained and the log of the above-described well as filed and that the same are true and correct. So help me God.

(Signature) Lee Mankin
709 Union National Bank Bldg.
(Address)

SUBSCRIBED AND SWORN to before me this 16th day of April 19 56

Wilma V. Shipman
Notary Public.

My commission expires May 24, 1956

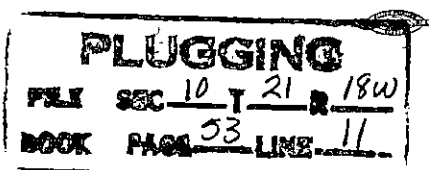

4-17-56

DRILLERS' LOG

No. 1 Browne
NW NW SE Section 10-21S-18W
Pawnee County, Kansas

<u>FROM</u>	<u>TO</u>	
0	230	Sand and shale
230	555	Shale
555	700	Sand
700	1135	Red bed and sand
1135	1165	Anhy. Shale
1165	1378	Anhy. shale and shells
1378	1685	Red bed and shale
1685	1745	Salt
1745	2155	Shale and shells
2155	2216	Lime and shale
2216	2478	Shale and shells
2478	2565	Lime and shale
2565	2890	Shale
2890	2960	Shale, lime and shells
2960	3262	Shale and lime
3262	3985	Lime
3985	4023	Conglomerate
4023	4026	Granite
	4026	Rotary Total Depth D&A

COMMENCED: 3-29-56

COMPLETED: 4-11-56

CASING RECORD:

Set 8-5/18" surface casing
at 227' with 200 sacks
cements, 200 Lbs. Calcium
chloride.

STATE OF KANSAS)
) S S
COUNTY OF SEDGWICK)

I hereby affirm that the above and foregoing is a true and correct copy of the formations encountered on the No. 1 Browne, NW NW SE Section 10-21S-18W, Pawnee County, Kansas, as reflected by the daily drilling reports.

KAN-TEX CONST., INC.

By: *Harvey E. Nightingale*
Harvey E. Nightingale

Subscribed and sworn to before me this 4-13-56

My Commission Expires: 6-9-56

Dora Lopez
Notary Public

PLUGGING
FILE SEC. 10 T 21 R 18W
BOOK PAGE 53 LINE 11