


STATE OF KANSAS  
STATE CORPORATION COMMISSION

WELL PLUGGING RECORD

Give All Information Completely  
Make Required Affidavit  
Mail or Deliver Report to:  
Conservation Division  
State Corporation Commission  
800 Bitting Building  
Wichita, Kansas

Pawnee County. Sec. 29 Twp. 21 Rge. (E) 18 (W)  
Location as "NE/CNW/SW" or footage from lines NE NE SE  
Lease Owner Sterling Drilling Co., et al.  
Lease Name Darnall Well No. 1  
Office Address Sterling, Kansas  
Character of Well (completed as Oil, Gas or Dry Hole) Dry Hole  
Date well completed November 28 19 54  
Application for plugging filed November 28 19 54  
Application for plugging approved November 28 19 54  
Plugging commenced November 28 19 54  
Plugging completed November 28 19 54  
Reason for abandonment of well or producing formation Dry Hole

NORTH

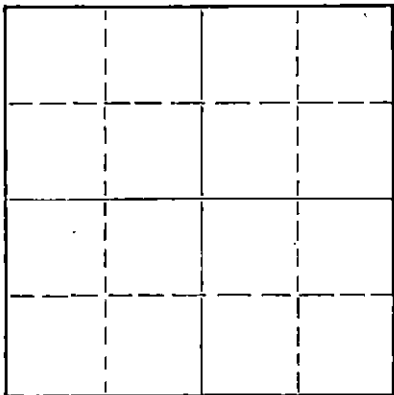

Locate well correctly on above  
Section Plat

If a producing well is abandoned, date of last production 19  
Was permission obtained from the Conservation Division or its agents before plugging was commenced? Yes

Name of Conservation Agent who supervised plugging of this well R. A. Rives  
Producing formation Depth to top Bottom Total Depth of Well 4202 Feet  
Show depth and thickness of all water, oil and gas formations.

OIL, GAS OR WATER RECORDS

CASING RECORD

FORMATION	CONTENT	FROM	TO	SIZE	PUT IN	PULLED OUT
				8-5/8"	300'	

Describe in detail the manner in which the well was plugged, indicating where the mud fluid was placed and the method or methods used in introducing it into the hole. If cement or other plugs were used, state the character of same and depth placed, from feet to feet for each plug set.

Filled hole through drill pipe to 290'. Pushed Halliburton plug down to 290' cemented with 125 sacks pozmix cement to the top.

(If additional description is necessary, use BACK of this sheet)

Name of Plugging Contractor Sterling Drilling Company  
Address Sterling, Kansas


STATE OF KANSAS, COUNTY OF RICE, ss.  
Rollin Mead (employee of owner) or (owner or operator) of the above-described well, being first duly sworn on oath, says: That I have knowledge of the facts, statements, and matters herein contained and the log of the above-described well as filed and that the same are true and correct. So help me God.

(Signature) Rollin Mead  
Sterling, Kansas (Address)

SUBSCRIBED AND SWORN TO before me this 30th day of November, 19 54

[Signature] Notary Public.

My commission expires

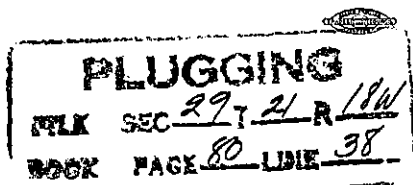

121-54

**STERLING DRILLING CO.**

STERLING, KANSAS

WELL LOG-----DARNALL #1

Location: NE NE SE, Section 29-21S-18W,  
Pawnee County, Kansas.OWNER: Sterling Drilling Company, et al.  
ROTARY DRILLING CONTRACTOR: Sterling Drilling CompanyCOMMENCED: 11-12-54 (w.r.)  
COMPLETED: 11-28-54 (w.r.)

TOTAL DEPTH: 4202'

LOG

0-300	Sand & Shale
300-1175	Shale, Sand & Red Bed
1175-1220	Anhydrite
1220-1970	Shale & Shells
1970-2380	Shale & Limestone
2380-2420	Limestone
2420-3345	Shale & Limestone
3345-3595	Limestone
3595-3653	Shale & Limestone
3653-3940	Limestone
3940-4018	Shale & Limestone
4018-4041	Conglomerate
4041-4098	Limestone
4098-4140	Limestone, Shale
4140-4153	Chert
4153-4202	Arbuckle T. D.

CASING RECORDRan 300' of 8-5/8" casing cemented  
with 150 sacks pozmix bulk cement  
and 3 sacks calcium chloride.Production

Plugged &amp; Abandoned

