

STATE OF KANSAS
STATE CORPORATION COMMISSION

Form CP-4


WELL PLUGGING RECORD

15-185-20040-0000

Give All Information Completely
Make Required Affidavit
Mail or Deliver Report to:
Conservation Division
State Corporation Commission
212 No. Market
Wichita, Kansas

Stafford County, Sec. 16 Twp. 23 Rge. 14 (W)

Location as "NE/CNW/SW" or footage from lines SW NW SW
Lease Owner Kathol Petroleum, Inc.
Lease Name Watson Well No. 1
Office Address 900 Sutton Place, Wichita, Kansas
Character of Well (completed as Oil, Gas or Dry Hole) Oil
Date well completed July 18, 19 67
Application for plugging filed April 7, 19 71
Application for plugging approved April 8, 19 71
Plugging commenced April 9, 19 71
Plugging completed April 21, 19 71
Reason for abandonment of well or producing formation Depleted

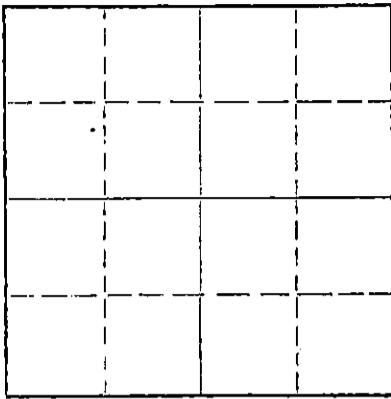

Locate well correctly on above Section Plat

If a producing well is abandoned, date of last production February 19 70
Was permission obtained from the Conservation Division or its agents before plugging was commenced? Yes

Name of Conservation Agent who supervised plugging of this well Russell Biberstein
Producing formation Simpson Depth to top Bottom Total Depth of Well 4015 Feet
Show depth and thickness of all water, oil and gas formations.

OIL, GAS OR WATER RECORDS

CASING RECORD

FORMATION	CONTENT	FROM	TO	SIZE	PUT IN	PULLED OUT
				8-5/8	260'	None
				5-1/2	4002'	750'

Describe in detail the manner in which the well was plugged, indicating where the mud fluid was placed and the method or methods used in introducing it into the hole. If cement or other plugs were used, state the character of same and depth placed, from feet to feet for each plug set.

Pumped 2 sacks hulls to T.D.
Pumped 15 sacks gel. and 100 sacks
cement into hole. Cement filled
up to 20' of surface.

RECEIVED
STATE CORPORATION COMMISSION
MAY 21 1971
CONSERVATION DIVISION
Wichita, Kansas

(If additional description is necessary, use BACK of this sheet)

Name of Plugging Contractor
Address

STATE OF KANSAS, COUNTY OF SEDGWICK, ss.
Homer J. Catt (employee of owner) or (owner or operator) of the above-described well, being first duly sworn on oath, says: That I have knowledge of the facts, statements, and matters herein contained and the log of the above-described well as filed and that the same are true and correct. So help me God.

(Signature) Homer J. Catt

Subscribed and sworn to before me this 20th day of May 19 71
My commission expires June 17, 1971
Dixie Lee Brown Notary Public.



DRILLERS LOG

#1 WATSON

KATHOL PETROLEUM, INC.

SW NW SW, SEC. 16-23S-14W

STAFFORD COUNTY, KANSAS

RECEIVED
STATE CORPORATION COMMISSION
DEC 29 1970
CONSERVATION DIVISION
Wichita, Kansas

15-185-20040-0000

Commenced: 7-3-67
Completed: 7-18-67
Elevation: 1982 KB

FROM	TO	REMARKS:
0	85	Sand
85	200	Sand & Shale
200	260	Shale
260	345	Red Bed
345	400	Sand
400	880	Shale - Red Bed
880	889	Shale - Red Bed
889	903	Anhydrite
903	1750	Shale & Shells
1750	2000	Shale & Lime
2000	2195	Lime Shale
2195	2390	Lime & Shale
2390	2420	Shale
2420	2575	Shale - Lime
2575	2785	Shale
2785	2913	Shale & Lime
2913	3055	Shale & Lime
3055	3160	Lime - Shale
3160	3252	Lime & Shale
3252	3360	Lime & Shale
3360	3445	Lime
3445	3550	Shale
3550	3605	Lime
3605	3650	Lime
3650	3705	Lime
3705	3720	Lime
3720	3730	Lime
3730	3770	Lime
3770	3825	Lime
3825	3873	Lime
3873	3879	Lime & Shale
3879	3908	Miss. Lime
3908	3923	Sand
3923	3930	Shale
3930	3971	Chert
3971	3995	Lime & Chert
3995	4015	Shale & Sand
	4015	R.T.D.

Set 260' of 8-5/8" csg.
w/200 sx. cement, 1% Gel.,
2% C.C.

TOPS: (Electric Log)

Heebner	3426
Brown Lime	3560
Lansing	3572
Bs. Kansas City	3806
Mississippian	3887
Kinderhook Sand	3903
Viola	3926
Simpson	3986
Sand	4000
T.D. (log)	4013
R.T.D.	4015

2600

I certify to the best of my knowledge and belief, the above represents a true and accurate driller's log record of the captioned well.

Don G. Calvin
Don G. Calvin

STATE OF KANSAS)
) SS.
COUNTY OF SEDGWICK)

Subscribed and sworn to before me this 24th day of July, 1967.

Ernest L. Smith
Notary Public