


STATE OF KANSAS
STATE CORPORATION COMMISSION

Form CP-4

Give All Information Completely
Make Required Affidavit
Mail or Deliver Report to:
Conservation Division
State Corporation Commission
212 No. Market
Wichita, Kansas

WELL PLUGGING RECORD

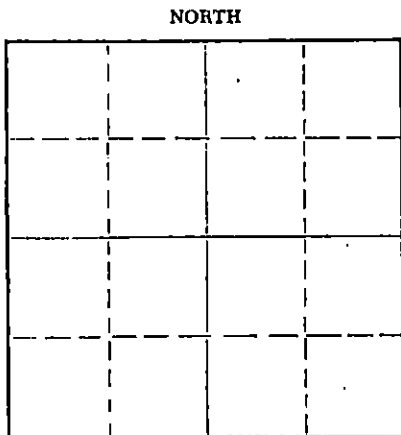

Locate well correctly on above
Section Plat

Pawnee County. Sec. 2 Twp. 21 Rge. 19 (E) (W)
Location as "NE/CNW/SE" or footage from lines SW SE SE
Lease Owner Mull Drilling Company
Lease Name Ideker Well No. 2
Office Address 1625 Wichita Plaza, Wichita, Kansas
Character of Well (completed as Oil, Gas or Dry Hole) Dry Hole
Date well completed 1/30 19 68
Application for plugging filed 19
Application for plugging approved 19
Plugging commenced 1/30 19 68
Plugging completed 1/30 19 68
Reason for abandonment of well or producing formation No commercial quantities of oil or gas encountered.
If a producing well is abandoned, date of last production 19
Was permission obtained from the Conservation Division or its agents before plugging was commenced? _____

Name of Conservation Agent who supervised plugging of this well Leo Massey
Producing formation _____ Depth to top _____ Bottom _____ Total Depth of Well 4280 Feet
Show depth and thickness of all water, oil and gas formations.

OIL, GAS OR WATER RECORDS

CASING RECORD

FORMATION	CONTENT	FROM	TO	SIZE	PUT IN	PULLED OUT
Surface hole	water	surface	413'	8 5/8"		left in
(see attached log)						

Describe in detail the manner in which the well was plugged, indicating where the mud fluid was placed and the method or methods used in introducing it into the hole. If cement or other plugs were used, state the character of same and depth placed, from _____ feet to _____ feet for each plug set.

Plug through drill pipe with 70 sacks cement at 540',
Mud to 40', bridge & 10 sacks cement. Plug rat hole
with 2 sacks cement.

RECEIVED
STATE CORPORATION COMMISSION
FEB 6 - 1968
CONSERVATION DIVISION
Wichita, Kansas

(If additional description is necessary, use BACK of this sheet)

Name of Plugging Contractor Donelson Drilling Company
Address 619 First Natl. Bank Bldg., Wichita, Kansas

STATE OF KANSAS, COUNTY OF SEDGWICK, ss.
James L. Donelson (employee of owner) or (owner or operator) of the above-described well, being first duly sworn on oath, says: That I have knowledge of the facts, statements, and matters herein contained and the log of the above-described well as filed and that the same are true and correct. So help me God.

(Signature) James L. Donelson
619 1st Natl. Bank Bldg., Wichita, Ks.
(Address)

SUBSCRIBED AND SWORN TO before me this 5th day of February, 19 68

Carolyn J. Scott
Carolyn J. Scott Notary Public.

My commission expires April 16, 1969

IDEKER #2

Mull Drilling Company

Total Depth: 4280'	Elevation: 2109 GL, 2114 KB
Contractor: Donelson Drilling Co.	Location: SW SE SE, 2-21-19
Commenced: 1/20/68	Pawnee County, Kansas
Completed: 1/29/68	Surface Casing Record: 406' 8 5/8" set @ 413' w/190 sx cmt.

<u>Formation:</u>	<u>Depth:</u>
Surface hole	413'
Shale	647'
Sand	785'
Shale	1237'
Shale & Shells	1810'
Lime & Shale	2307'
Lime	2444'
Lime & Shale	3666'
Shale	3695'
Lime	3984'
Lime & Shale	4214'
Lime & Sand	4250'
Chert	4280' TD

RECEIVED
STATE CORPORATION COMMISSION
FEB 6 - 1968
CONSERVATION DIVISION
Wichita, Kansas

I hereby certify the foregoing statements are true and correct to the best of my knowledge and belief.

DONELSON DRILLING COMPANY

James L. Donelson
James L. Donelson

STATE OF KANSAS)
) SS
COUNTY OF SEDGWICK)

Subscribed and sworn to before me, a Notary Public in and for said county and state, this 1st day of February, 1968.

My Commission expires: April 16, 1969.

Carolyn L. Scott
Carolyn L. Scott