


WELL PLUGGING RECORD

Give All Information Completely
Make Required Affidavit
Mail or Deliver Report to:
Conservation Division
State Corporation Commission
211 No. Broadway
Wichita, Kansas

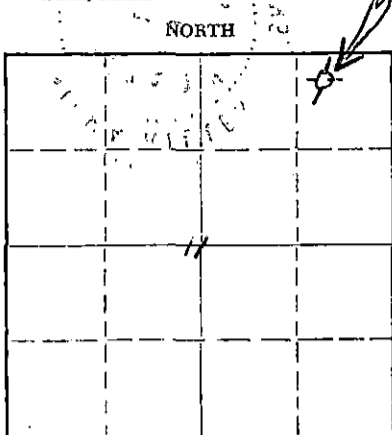

Locate well correctly on above
Section Plat

Pawnee County, Sec. 11 Twp. 21S Rge. 19W (E) (W)
Location as "NE/CNW/SW" or footage from lines NW NE NE
Lease Owner Earl Harter Oil Company
Lease Name Mezger Well No. 1
Office Address 1010 Barksdale-Shreveport Blvd. Shreveport, La.
Character of Well (completed as Oil, Gas or Dry Hole) Oil
Date well completed Jan 2 1968
Application for plugging filed September 18 1968
Application for plugging approved Sept. 18 1968
Plugging commenced Sept. 20, 1968 at 9.AM 1968
Plugging completed " 12:45PM 1968
Reason for abandonment of well or producing formation Salt water

If a producing well is abandoned, date of last production July 1968
Was permission obtained from the Conservation Division or its agents before plugging was commenced? Yes

Name of Conservation Agent who supervised plugging of this well Leo Massey
Producing formation Cheerokee Depth to top 4196 Bottom 4201 Total Depth of Well 4288 Feet
Show depth and thickness of all water, oil and gas formations.

OIL, GAS OR WATER RECORDS

CASING RECORD

FORMATION	CONTENT	FROM	TO	SIZE	PUT IN	PULLED OUT
						none

Describe in detail the manner in which the well was plugged, indicating where the mud fluid was placed and the method or methods used in introducing it into the hole. If cement or other plugs were used, state the character of same and depth placed, from _____ feet to _____ feet for each plug set.

Mixed 30 sacks gel, topped with 90 sks cement in annulus and 45 sacks cement in 4 1/2" csg.

RECEIVED
STATE CORPORATION COMMISSION
SEP 30 1968
CONSERVATION DIVISION
Wichita, Kansas

(If additional description is necessary, use BACK of this sheet)

Name of Plugging Contractor Allied Cementing Co., Inc.
Address Russell, Kansas

STATE OF Kansas COUNTY OF Sedgwick, ss.
J. Copeland Landes (employee of owner) or (owner or operator) of the above-described well, being first duly sworn on oath, says: That I have knowledge of the facts, statements, and matters herein contained and the log of the above-described well as filed and that the same are true and correct. So help me God.

(Signature) J. Copeland Landes

(Address) _____

SUBSCRIBED AND SWORN TO before me this 27th day of September, 1968



My commission expires July 27, 1971

Wilma Riller
Notary Public.

DRILLER'S LOG

COMPANY: Kern Drilling Co. Inc., 337 Union Center, Wichita
 CONTRACTOR: Hellar Drilling Company, Inc., Wichita, Kansas
 LEASE: #1 Mezger
 LOCATION: NW NE NE 11-21S-19W, Pawnee County, Kansas
 COMMENCED: December 11, 1967
 COMPLETED: December 21, 1967
 CASING: Set 8 5/8" @ 247'KB/collar & cellar/185 sacks cement
 Set 4 1/2" casing @ 4283'/300 sacks cement

0-248	Shale & Red Bed
248-470	Shale
470-1215	Shale, sand & Red Bed
1215-1655	Shale & Red Bed
1655-2110	Salt Section
2110-2519	Ft. Riley Chert & Lime
2519-3783	Lime & Shale
3783-3860	Lime (K.C.)
3860-3970	K. C.
3970-4011	Lime
4011-4204	Lime & Shale
4204-4218	Cherokee Sand & Shale
4218-4250	Sand & Shale
4250-4263	Cong.
4263-4288	Miss.
4288	Rotary Total Depth

STATE OF KANSAS)
) SS
 COUNTY OF SEDGWICK)

I, D. L. Hellar, do hereby certify that the above and foregoing is a true and correct copy of the log of the #1 Mezger, located in NW NE NE 11-21S-19W, Pawnee County, Kansas, as reflected by the files of the Hellar Drilling Company, Inc.

HELLAR DRILLING COMPANY, INC.

By: *D. L. Hellar*
 President - D. L. Hellar

Subscribed and sworn to before me, a Notary Public, in and for Sedgwick County, Kansas, this 29th day of December, 1967.

Catherine Darcey
 Notary Public - Catherine Darcey

My Commission Expires: March 25, 1968.

RECEIVED
 STATE CORPORATION COMMISSION
 SEP 18 1968
 CONSERVATION DIVISION
 Wichita, Kansas