


STATE OF KANSAS
STATE CORPORATION COMMISSION

WELL PLUGGING RECORD

Give All Information Completely
Make Required Affidavit
Mail or Deliver Report to
Conservation Division
State Corporation Comm.
245 North Water
Wichita, KS 67202

Pawnee County, Sec. 11 Twp. 21S Rge. 19W E/W
Location as "NE/CNW $\frac{1}{4}$ SW $\frac{1}{4}$ " or footage from lines _____
NW SE NW
Lease Owner PICKRELL DRILLING COMPANY
Lease Name LEADLEY "A" Well No. 1
Office Address 205 LITWIN BLDG., WICHITA, KS. 67202
Character of Well (Completed as Oil, Gas or Dry Hole) _____
Dry Hole
Date Well completed 2-16-77 19
Application for plugging filed 2-16-77 19
Application for plugging approved 2-16-77 19
Plugging commenced 2-16-77 19
Plugging completed 2-16-77 19
Reason for abandonment of well or producing formation _____
Dry Hole

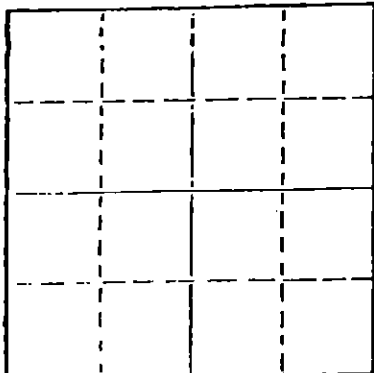

Locate well correctly on above
Section Plot

If a producing well is abandoned, date of last production _____ 19

Was permission obtained from the Conservation Division or
its agents before plugging was commenced? Yes

Name of Conservation Agent who supervised plugging of this well Leo Massey
Producing formation _____ Depth to top _____ Bottom _____ Total Depth of Well 4298
Show depth and thickness of all water, oil and gas formations.

OIL, GAS OR WATER RECORDS

CASING RECORD

FORMATION	CONTENT	FROM	TO	SIZE	PUT IN	PULLED OUT
				8 5/8	320	NONE

Describe in detail the manner in which the well was plugged, indicating where the mud fluid
was placed and the method or methods used in introducing it into the hold. If cement or other
plugs were used, state the character of same and depth placed, from _____ feet to
_____ feet for each plug set.

RECEIVED
STATE CORPORATION COMMISSION
MAR 08 1977
CONSERVATION DIVISION
Wichita, Kansas

Plug 450ft. w/50 sacks
240ft. w/25 sacks
40ft. w/10 sacks Comp. 7:15AM

(If additional description is necessary, use BACK of this sheet)

Name of Plugging Contractor PICKRELL DRILLING COMPANY

STATE OF Kansas COUNTY OF Sedgwick, ss.
C. W. Sebitts (employee of owner) or (owner or operator)

of the above-described well, being first duly sworn on oath, says: That I have knowledge of
the facts, statements, and matters herein contained and the log of the above-described well
as filed and that the same are true and correct. So help me God.

BY: C. W. Sebitts
(Signature) _____
205 Litwin Bldg., Wichita, Ks. 67202
(Address)

SUBSCRIBED AND SWORN TO before me this 1 day of March, 19 77

My commission expires _____

Jo Ann Sarver
Notary Public.



ROTARY DRILLING LOG

COMPANY: PICKRELL DRILLING COMPANY
 205 LITWIN BLDG.
 WICHITA, KS. 67202
 LOCATION: Leadley "A" #1
 NW SE NW 11-21S-19W
 Pawnee Co., Ks.
 CONTRACTOR: **PICKRELL DRILLING COMPANY**
 Wichita, Kansas

Rotary Drilling Commenced 2-5-77
 Rotary Drilling Completed 2-16-77

CASING RECORD: Surface pipe 8 5/8" @ 320' with 175 sx. Comp. 2-5-77 5:30PM

LOG

(Figures indicate bottom of formation — measurements from top of rotary bushing.)

Shells & Sd.	265
Shale	330
Shale	677
Sand	990
Shale	1255
Shale & Shells	1286
Shale & Shells	1560
Shale & Shells	1980
Shale & Lime	2150
Lime & Shale	2315
Lime & Shale	2495
Lime & Shale	2655
Lime & Shale	2830
Lime & Shale	3000
Lime & Shale	3105
Lime & Shale	3265
Lime & Shale	3385
Lime & Shale	3530
Lime & Shale	3675
Lime & Shale	3761
Lime	3780
Lime & Shale	3860
Lime & Shale	3950
Lime & Shale	4030
Lime & Shale	4120
Lime & Shale	4190
Lime & Snad	4199
Lime	4208
Lime & Shale	4229
Lime & Sand	4265
Lime & Shale	4298

RECEIVED
 STATE CORPORATION COMMISSION

MAR 08 1977

CONSERVATION DIVISION
 Wichita, Kansas

The undersigned, C. W. Sebitts, Attorney-in-Fact for PICKRELL DRILLING COMPANY, hereby certifies in behalf of said Company, that the above is a true and correct log of the formation encountered in drilling the above well as reflected by the Daily Drilling Reports.

PICKRELL DRILLING COMPANY
 By [Signature]
 Attorney-in-Fact
 C. W. Sebitts

STATE OF KANSAS }
 COUNTY OF SEDGWICK } ss.:

On this 1 day of March, 1977, before me the undersigned, a Notary Public, in and for the County and State aforesaid, personally appeared C. W. Sebitts, to me known to be the identical person who subscribed the name of PICKRELL DRILLING COMPANY to the foregoing instrument as its Attorney-in-Fact and acknowledged to me that he executed the same as his free and voluntary act and deed, and as the free and voluntary act and deed of such company, for the uses and purposes therein set forth.

Given under my hand and seal of office the day and year last above written.

My commission expires: _____

JO ANN SARVER
 Sedgwick County, Ks.
 My Appt. Exp. 2-18-80

[Signature]
 Notary Public
 Jo Ann Sarver