


STATE OF KANSAS
STATE CORPORATION COMMISSION

Form CP-4

Give All Information Completely
Make Required Affidavit
Mail or Deliver Report to:
Conservation Division
State Corporation Commission
211 No. Broadway
Wichita, Kansas

WELL PLUGGING RECORD

PAWNEE County. Sec. 15 Twp. 21 Rge. 19 (E) (W)
Location as "NE/CNW%SW%" or footage from lines NW NW NW
Lease Owner SANTA-FE PIPE & SUPPLY, INC.
Lease Name WEIDEN Well No. 1
Office Address P.O. BOX 562 - GREAT BEND, KANSAS
Character of Well (completed as Oil, Gas or Dry Hole) WASHDOWN
Date well completed 19____
Application for plugging filed AUGUST 11 19 65
Application for plugging approved AUGUST 12 19 65
Plugging commenced AUGUST 23 19 65
Plugging completed NOVEMBER 2 19 65
Reason for abandonment of well or producing formation DRY

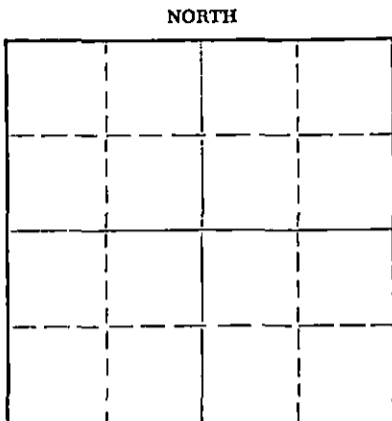

Locate well correctly on above
Section Plat

If a producing well is abandoned, date of last production 19____
Was permission obtained from the Conservation Division or its agents before plugging was commenced? YES

Name of Conservation Agent who supervised plugging of this well MR. ELDON PETTY
Producing formation _____ Depth to top _____ Bottom _____ Total Depth of Well 4296' Feet
Show depth and thickness of all water, oil and gas formations.

OIL, GAS OR WATER RECORDS

CASING RECORD

FORMATION	CONTENT	FROM	TO	SIZE	PUT IN	PULLED OUT
				8 5/8"	1020'	NONE
				4 1/2"	4296'	3993.57'

Describe in detail the manner in which the well was plugged, indicating where the mud fluid was placed and the method or methods used in introducing it into the hole. If cement or other plugs were used, state the character of same and depth placed, from _____ feet to _____ feet for each plug set.

4296'	-	4175'	-	SAND
4175'	-	4127'	-	4 SACKS CEMENT
4127'	-	300'	-	MUD
300'	-	BASE	-	5 SACKS MUD - 100 SACKS CEMENT (PUMPED)

RECEIVED
STATE CORPORATION COMMISSION

NOV 23 1965 11-23-65

CONSERVATION DIVISION
WICHITA, KANSAS

(If additional description is necessary, use BACK of this sheet)

Name of Plugging Contractor _____
Address _____

STATE OF KANSAS COUNTY OF BARTON, ss.
T.L. NUTT (employee of owner) or (owner or operator) of the above-described

well, being first duly sworn on oath, says: That I have knowledge of the facts, statements, and matters herein contained and the log of the above-described well as filed and that the same are true and correct. So help me God.

(Signature) *T.L. Nutt*

P.O. BOX 562 - GREAT BEND, KANSAS (Address) 65

Subscribed and Sworn to before me this 15th day of NOVEMBER 19 65

My commission expires JULY 31, 1965 *Mary M. Guzman* Notary Public.