


STATE OF KANSAS
STATE CORPORATION COMMISSION

Form CP-4

Give All Information Completely
Make Required Affidavit
Mail or Deliver Report to:
Conservation Division
State Corporation Commission
212 No. Market
Wichita, Kansas 67202

WELL PLUGGING RECORD

NORTH

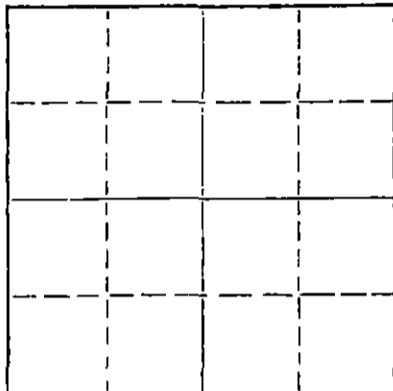

Locate well correctly on above
Section Plat

Pawnee County, Sec. 15 Twp. 21S Rge. 19W (E) (W)X
Location as "NE/CNW/SW" or footage from lines SE SW NW
Lease Owner Real Petroleum Co.
Lease Name E. M. Wieden Well No. 1-V
Office Address 6810 W. Kellogg, Wichita, Kansas
Character of Well (completed as Oil, Gas or Dry Hole) D & A
Date well completed June 7 1971
Application for plugging filed June 7 1971
Application for plugging approved June 7 1971
Plugging commenced June 7 1971
Plugging completed June 7 1971
Reason for abandonment of well or producing formation D & A

If a producing well is abandoned, date of last production 19
Was permission obtained from the Conservation Division or its agents before plugging was commenced? yes

Name of Conservation Agent who supervised plugging of this well Leo F. Massey
Producing formation Depth to top Bottom Total Depth of Well 4305 Feet
Show depth and thickness of all water, oil and gas formations.

OIL, GAS OR WATER RECORDS

CASING RECORD

FORMATION	CONTENT	FROM	TO	SIZE	PUT IN	PULLED OUT
				8 5/8"	435'	-0-

Describe in detail the manner in which the well was plugged, indicating where the mud fluid was placed and the method or methods used in introducing it into the hole. If cement or other plugs were used, state the character of same and depth placed, from feet to feet for each plug set.

Plugged hole - 1st plug @ 450'
w/50 sx, 2nd plug @ 240' w/25 sx
3rd plug @ 40' w/10 sx.


RECEIVED
STATE CORPORATION COMMISSION
JUN 21 1971
CONSERVATION DIVISION
Wichita, Kansas

(If additional description is necessary, use BACK of this sheet)

Name of Plugging Contractor Red Tiger Drilling Co.
Address 1720 Wichita Plaza, Wichita, Kansas

STATE OF Kansas, COUNTY OF Sedgwick, ss.
Jim Farrice (employee of owner) or (owner or operator) of the above-described well, being first duly sworn on oath, says: That I have knowledge of the facts, statements, and matters herein contained and the log of the above-described well as filed and that the same are true and correct. So help me God.

(Signature) Jim Farrice
1720 Wichita Plaza, Wichita, Kansas 67202
(Address)

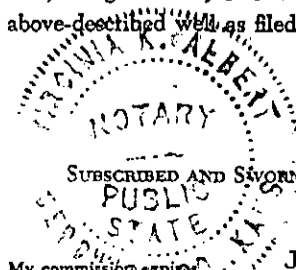

SUBSCRIBED AND SWORN to before me this 9th day of June, 1971

Virginia K. Albert
Notary Public.

DRILLERS LOG

E. M. Wieden I-V

CASING RECORD:

8 5/8" @ 442'
w/225 sx cement

COMPANY:

Real Petroleum Company

CONTRACTOR:

Red Tiger Drilling Co.

COMMENCED:

May 26, 1971

COMPLETED:

June 7, 1971

DESCRIPTION:

SE SW NW
15-21S-19W
Pawnee County,
Kansas

TOTAL DEPTH: 4305'

ELEVATION:

<u>FORMATION</u>	<u>FROM</u>	<u>TO</u>	<u>REMARKS</u>
Surface	0	443	
Shale & Red Bed	443	504	
Sand	504	512	
Shale & Red Bed	512	585	
Blame	585	596	
Red Bed, Shale	596	693	
Sand	693	838	
Shale & Red Bed	838	1258	
Anhydrite	1258	1288	
Shale & Shells	1288	1745	
Shale & Lime Shells	1745	2020	
Lime & Shale	2020	2235	
Lime	2235	2370	
Lime & Shale	2370	3415	
Lime	3415	3485	
Lime & Shale	3485	3713	
Lime	3713	4059	
Lime & Shale	4059	4305	

RECEIVED
STATE CORPORATION COMMISSION
JUN 21 1971
CONSERVATION DIVISION
Wichita, Kansas

I certify that this is a true and correct copy of the above log to the best of my knowledge.

RED TIGER DRILLING COMPANY

Jim Farrice
Jim Farrice

Subscribed and sworn to before me this 9th day of June, 1971.

Virginia K. Albert
Notary Public



My Commission Expires:

July 23, 1971

NOTED
Fidelity Union State
Bank