


STATE OF KANSAS
STATE CORPORATION COMMISSION

Give All Information Completely
Make Required Affidavit
Mail or Deliver Report to
Conservation Division
State Corporation Commission
245 North Water
Wichita, KS 67202

FORM CP-4

WELL PLUGGING RECORD

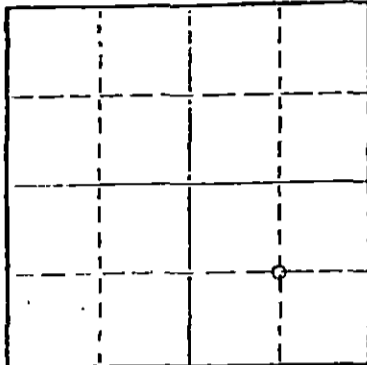

Locate well correctly on above Section Plat

Pawnee County. Sec. 15 Twp. 21 Rge. 19 (E) W (W)
Location as "NE/CNWKSW" or footage from lines C-SE 1/2
Lease Owner Benson Mineral Group, Inc.
Lease Name Shoemaker "A" Well No. 1-15
Office Address 1536 Cole Blvd., Suite 220, Golden, Colo. 80401
Character of Well (completed as Oil, Gas or Dry Hole) Dry hole
Date well completed 8-23 19 83
Application for plugging filed 5-9 19 85
Application for plugging approved 5-13 19 85
Plugging commenced 6-10 19 85
Plugging completed 6-17 19 85
Reason for abandonment of well or producing formation No gas

If a producing well is abandoned, date of last production 19
Was permission obtained from the Conservation Division or its agents before plugging was commenced? Yes

Name of Conservation Agent who supervised plugging of this well Steve Durant
Producing formation Chase Group Depth to top 2200 Bottom 2332 Total Depth of Well 2385 Feet
Show depth and thickness of all water, oil and gas formations.

OIL, GAS OR WATER RECORDS

CASING RECORD

FORMATION	CONTENT	FROM	TO	SIZE	PUT IN	PULLED OUT
Chase Group	Water	0	950'	7"	950'	0
		0	2384'	4 1/2"	2384'	1045.68

Describe in detail the manner in which the well was plugged, indicating where the mud fluid was placed and the method or methods used in introducing it into the hole. If cement or other plugs were used, state the character of same and depth placed, from _____ feet to _____ feet for each plug set.

6-10-85 - Establish rate down 4 1/2 csg at 3 BPM 1000#. Pump 1 sx cottonseed hulls followed by 30 sx 60-40 Poz, 2% gel. Pumped 4 1/2" rubber plug to 1200' at 2200# max. Plug from 2201 to 1200'.
6-12-85 - Pull tension on csg back off and pull 25 its csg 1045.68.
6-17-85 - Pump 1 sx cottonseed hulls, pump 150 sx 60-40 Poz, 6% gel, 1200' to 0'.

(If additional description is necessary, use BACK of this sheet)

Name of Plugging Contractor Hembree Well Service
Address Box 458, Ness City, Kansas

STATE OF _____ COUNTY OF _____ ss.

_____ (employee of owner) or (owner or operator) of the above-described well, being first duly sworn on oath, says: That I have knowledge of the facts, statements, and matters herein contained and the log of the above-described well as filed and that the same are true and correct. So help me God.

(Signature) James S. Jameson James S. Jameson
Benson Mineral Group, 1536 Cole Blvd., Suite 220,
(Address) Golden, CO 80401

Subscribed and Sworn to before me this 21st day of June, 1985
Bonnie L. Linger
Notary Public.

My commission expires MAY 29, 1988

RECEIVED
STATE CORPORATION COMMISSION

JUN 24 1985

CONSERVATION DIVISION
Wichita, Kansas