


WELL PLUGGING RECORD

Give All Information Completely
Make Required Affidavit
Mail or Deliver Report to:
Conservation Division
State Corporation Commission
800 Bittling Building
Wichita, Kansas

Pawnee County, Sec. 25 Twp. 21 Rge. 19 (E) (W)

Location as "NE/CNWxSWx" or footage from lines SE SE NW
Lease Owner Welch & Olsson Drilling Company, Inc.
Lease Name Proffitt Well No. 1
Office Address 203 Rule Bldg. Wichita 2, Kansas
Character of Well (completed as Oil, Gas or Dry Hole) D & A
Date well completed 12-22 19 55
Application for plugging filed 12-23 19 55
Application for plugging approved 12-23 19 55
Plugging commenced 12-23 19 55
Plugging completed 12-23 19 55
Reason for abandonment of well or producing formation D & A

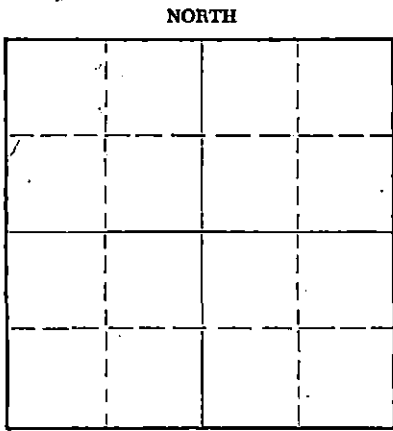

Locate well correctly on above Section Plat

If a producing well is abandoned, date of last production None 19____
Was permission obtained from the Conservation Division or its agents before plugging was commenced? Yes

Name of Conservation Agent who supervised plugging of this well R. M. Brundage, Box 283, Holsington, Ks.
Producing formation _____ Depth to top _____ Bottom _____ Total Depth of Well _____ Feet
Show depth and thickness of all water, oil and gas formations.

OIL, GAS OR WATER RECORDS

CASING RECORD

FORMATION	CONTENT	FROM	TO	SIZE	PUT IN	PULLED OUT
				8 5/8"	190'	None

Describe in detail the manner in which the well was plugged, indicating where the mud fluid was placed and the method or methods used in introducing it into the hole. If cement or other plugs were used, state the character of same and depth placed, from _____ feet to _____ feet for each plug set.

Pumped hole full of drilling mud. Set plug
Cemented and displaced with 100 sacks of cement
with Service Truck

Name of Plugging Contractor Welch & Olsson Drilling Company, Inc. (If additional description is necessary, use BACK of this sheet)
Address 203 Rule Bldg. Wichita, Kansas

STATE OF Kansas, COUNTY OF Sedgwick, ss.
R. E. Welch (employee or owner) or (owner or operator) of the above-described well, being first duly sworn on oath, says: That I have knowledge of the facts, statements, and matters herein contained and the log of the above-described well as filed and that the same are true and correct. So help me God.

(Signature) [Signature]
203 Rule Bldg. Wichita, Kansas (Address)

SUBSCRIBED AND SWORN TO before me this 9th day of January, 19 56

My commission expires June 12, 1959
Edith Erker Notary Public.

PLUGGING
FILE SEC 25-21-19N
BOOK PAGE 26 LINE 41

JAN 10 1956 1-10-56
CONSERVATION DIVISION
Wichita, Kansas

WELL LOG.

WELCH & OLSSON DRILLING COMPANY, INC.

ELEVATION: 2068 R.B.

CONTRACTOR: WELCH & OLSSON DRILLING COMPANY, INC.
203 Rule Bldg.,
Wichita, Kansas.

Comm. Drlg: 12-9-55

Compl. Drlg: 12-22-55

PROFFITT #1
SE SE NW 25-21-19W, Pawnee County, Kansas.

Production: D & A.

Casing Record.

Set 190' of 8 5/8" with 175 sacks of cement.

(Figures indicated bottom of formations.)

<u>FORMATIONS</u>	<u>DEPTHS</u>	<u>FORMATION TOPS.</u>
Shale:	315	Heebner: 3602 (-1534)
Shale & Shells & Red Bed:	650	Lansing-Kansas City: 3677 (-1609)
Dakota Sand:	735	Conglomerate-Shaley: 4138 (-2070)
Red Bed & Shale:	1125	Conglomerate-Cherty: 4170 (-2102)
Shale & Shells:	1168	Mississippi: 4235 (-2167)
Anhydrite:	1192	Kinderhook: 4312 (-2244)
Shale & Shells:	1940	Viola Lime: 4333 (-2265)
Shale W/Lime Streaks:	2215	
Lime:	2245	
Lime & Shale:	2290	
Lime (Sandy)	2335	
Shale & Lime:	2480	
Lime & Shale:	2685	
Shale W/Lime Streaks:	2805	
Shale & Lime:	2950	
Shale & Lime Streaks:	3000	
Lime & Shale:	3125	
Shale & Shells:	3250	
Shale & Lime:	3340	
Lime & Shale:	3455	
Lime:	3985	
Lime & Shale:	4150	
Conglomerate:	4205	
Cherty Conglomerate:	4284	
Cherty Conglomerate--Viola Lime:	4335	
Lime:	4355 T. D.	

STATE OF KANSAS,)
) SS:
SEDGWICK COUNTY,)

I hereby certify that the above is a true and correct copy of Drillers Log of well drilled in the SE SE NW of Section 25, Township 21 South, Range 19 West, Pawnee County, Kansas.

WELCH & OLSSON DRILLING COMPANY, INC.

BY R. E. Welch
R. E. WELCH

Subscribed and sworn to before me this 9th day of January, 1956

Seesh Shew
Notary Public.My commission expires:
June 12, 1959