

WELL PLUGGING RECORD

Give All Information Completely  
Make Required Affidavit  
Mail or Deliver Report to:  
Conservation Division  
State Corporation Commission  
800 Bittling Building  
Wichita, Kansas

Stafford County, Sec. 16 Twp. 23 Rge. 14 (W)

Location as "NE/CNW%SW%" or footage from lines NW SW SE

Lease Owner Deep Rock Oil Corporation

Lease Name M. B. Beaver Well No. 1

Office Address Box 1051, Tulsa, Oklahoma

Character of Well (completed as Oil, Gas or Dry Hole) Dry Hole

Date well completed August 9, 1954

Application for plugging filed August 9, 1954

Application for plugging approved August 9, 1954

Plugging commenced August 9, 1954

Plugging completed August 9, 1954

Reason for abandonment of well or producing formation Dry


If a producing well is abandoned, date of last production 19

Was permission obtained from the Conservation Division or its agents before plugging was commenced? Yes, verbal approval obtained before plugging

Name of Conservation Agent who supervised plugging of this well M. A. Rives

Producing formation \_\_\_\_\_ Depth to top \_\_\_\_\_ Bottom \_\_\_\_\_ Total Depth of Well 4039 Feet

Show depth and thickness of all water, oil and gas formations.

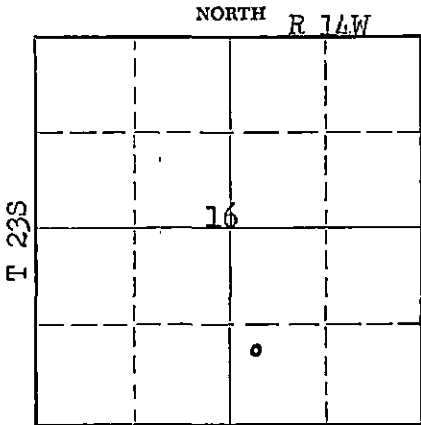

Locate well correctly on above Section Plat

OIL, GAS OR WATER RECORDS

CASING RECORD

FORMATION	CONTENT	FROM	TO	SIZE	PUT IN	PULLED OUT
				10-3/4"	249'	None

Describe in detail the manner in which the well was plugged, indicating where the mud fluid was placed and the method or methods used in introducing it into the hole. If cement or other plugs were used, state the character of same and depth placed, from \_\_\_\_\_ feet to \_\_\_\_\_ feet for each plug set.

Filled with heavy rotary mud to 230 feet.  
Set Halliburton wood plug at 235 feet and  
dumped 1/2 sack hulls and pushed plug to 240  
feet. Dumped in 25 sacks of cement thru drill  
pipe. Filled with rotary mud to 30 feet. Set  
wood plug at 30 feet, dumped in 1/3 sack hulls  
and filled with 15 sacks cement to top of pipe  
and into cellar.

(If additional description is necessary, use BACK of this sheet)

Name of Plugging Contractor Gabbert-Jones Drilling Company

Address 507 Orpheum Building, Wichita, Kansas

STATE OF KANSAS, COUNTY OF SEDGWICK, ss.

R. D. Michaels (employee of owner) or (owner/operated) of the above-described well, being first duly sworn on oath, says: That I have knowledge of the facts, statements, and matters herein contained and the log of the above-described well as filed and that the same are true and correct. So help me God.

(Signature) R. D. Michaels

701 Petroleum Building  
(Address)

SUBSCRIBED AND SWORN TO before me this 20th day of August, 1954

My commission expires October 23, 1957

Francis C. Newton  
Notary Public.

RECEIVED  
STATE CORPORATION COMMISSION

AUG 21 1954 8-21-54

CONSERVATION DIVISION  
Wichita, Kansas

PLUGGING  
FILE SEC 16 T 23 R 14W  
PAGE 55 LINE 1

GABBERT-JONES DRILLING COMPANY  
WICHITA, KANSAS  
DRILLERS WELL LOG

M. B. BEAVER #1  
 NW SW SE, SECTION 16-23-14  
 STAFFORD COUNTY, KANSAS  
 COMMENCED 7-26-54  
 COMPLETED 8-9-54

15-185-30402-0000

<u>DEPTH</u>		<u>FORMATION</u>	<u>REMARKS</u>
FROM	TO		
0	190	SAND & SHALE	
190	250	SHALE & SHELLS	RAN 250' OF 10 3/4" CASING CEMENTED W/175 SACKS CEMENT.
250	520	SHALE, SHELLS & SAND	
520	830	RED BED	
830	860	ANHYDRITE	
860	1365	SHALE & SHELLS	
1365	1705	SHALE, SHELLS & LIME	
1705	2260	LIME & SHALE	
2260	2525	LIME	
2525	3105	LIME & SHALE	
3105	3854	LIME	
3854	3910	LIME & SHALE	
3910	3915	CHERT	
3915	3960	CHERTY LIME	
3960	3977	LIME	
3977	3994	SIMPSON SAND	
3994	4024	SHALE	
4024	4039	LIME	
4039	TD		DRY & ABANDONED

EXECUTED THIS 16TH DAY OF AUGUST, 1954

C. L. Gabbert

STATE OF KANSAS )  
 ) SS  
 COUNTY OF SEDGWICK)

BEFORE ME, THE UNDERSIGNED, A NOTARY PUBLIC, WITHIN AND FOR SAID COUNTY AND STATE ON THIS 16th DAY OF August, 1954 PERSONALLY APPEARED C. L. Gabbert TO ME PERSONALLY KNOWN TO BE THE IDENTICAL PERSON WHO EXECUTED THE WITHIN AND FOREGOING INSTRUMENT AND ACKNOWLEDGED TO ME THAT HE EXECUTED THE SAME AS HIS FREE AND VOLUNTARY ACT AND DEED FOR THE USES AND PURPOSES THEREIN SET FORTH.

IN WITNESS WHEREOF, I HAVE HEREUNTO SET MY HAND AND OFFICIAL SEAL THE DAY AND YEAR LAST ABOVE WRITTEN.

MY COMMISSION EXPIRES 10-27-54

Sumner E. Hall  
 NOTARY PUBLIC

