


Give All Information Completely
Make Required Affidavit
Mail or Deliver Report to:
Conservation Division
State Corporation Commission
P. O. Box 17027
Wichita, Kansas 67217
NORTH

WELL PLUGGING RECORD

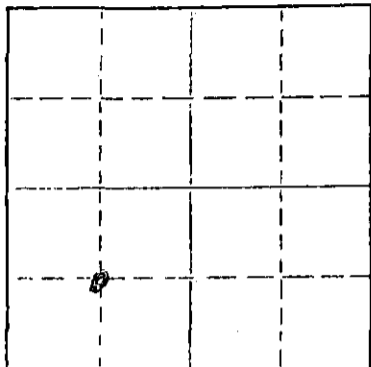

Locate well correctly on above Section Plat

Finney County. Sec. 7 Twp. 23 Rge. 31 (E) (W) X
Location as "NE/CNW&SW" or footage from lines C SW 1/4
Lease Owner Jones & Pellow Oil Co.
Lease Name Vinduska Well No. 1
Office Address 2821 N. W. 50th St. Okla. City, Okla. 73112
Character of Well (completed as Oil, Gas or Dry Hole) Dry Hole
Date well completed _____ 19____
Application for plugging filed 4-11- 19 75
Application for plugging approved 4-11- 19 75
Plugging commenced 4-15 19 75
Plugging completed 4-15 19 75
Reason for abandonment of well or producing formation _____
Non-commercial
If a producing well is abandoned, date of last production _____ 19____
Was permission obtained from the Conservation Division or its agents before plugging was commenced? Yes

Name of Conservation Agent who supervised plugging of this well Clarence Thomas
Producing formation _____ Depth to top _____ Bottom _____ Total Depth of Well 2760
Show depth and thickness of all water, oil and gas formations.

OIL, GAS OR WATER RECORDS

CASING RECORD

FORMATION	CONTENT	FROM	TO	SIZE	PUT IN	PULLED OUT
				8 5/8	617	none
				5 1/2	2759	none

Describe in detail the manner in which the well was plugged, indicating where the mud fluid was placed and the method or methods used in introducing it into the hole. If cement or other plugs were used, state the character of same and depth placed, from _____ feet to _____ feet for each plug set.

Pumped 2 sks. of hulls & 20 sks. of cement to 2500 Displaced W/ mud to 900'
Pumped 40 sks. of cement from 900 to 500'
Displaced W/ mud to 60' Spotted 10 sks. of cement from 60 to 0'

RECEIVED
STATE CORPORATION COMMISSION
MAY 19 1975
CONSERVATION DIVISION
MAY 19 1975

(If additional description is necessary, use BACK of this sheet)
Name of Plugging Contractor Sargents Casing Pulling Service Kansas No. 511
Address Box 506 Liberal, Kansas 67901

STATE OF _____ COUNTY OF _____, ss.
Edward D. Keleher

(employee of owner) or (owner or operator) of the above-described well, being first duly sworn on oath, says: That I have knowledge of the facts, statements, and matters herein contained and the log of the above-described well as filed and that the same are true and correct. So help me God.

(Signature) Edward D. Keleher
2821 N. W. 50th St. Okla. City, Okla. 73112
(Address)

SUBSCRIBED AND SWORN TO before me this 15th day of May, 19 75

My commission expires August 5, 1978
 Evelyn Hudson
Notary Public.