


Give All Information Completely
Make Required Affidavit
Mail or Deliver Report to:
Conservation Division
State Corporation Commission
800 Bitting Building
Wichita, Kansas

WELL PLUGGING RECORD

NORTH

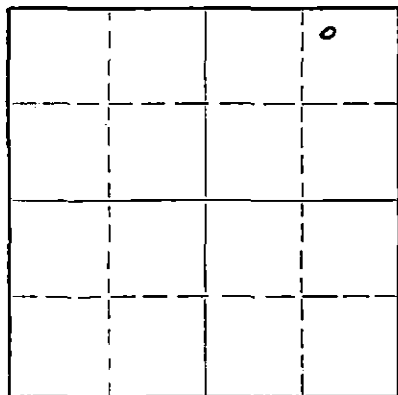

Locate well correctly on above Section Plat

Stafford County, Sec. 2, Twp. 23S Rge. (E) 14 (W)
Location as "NE/CNW/SWK" or footage from lines NW 1/4 - NE 1/4 - NE 1/4
Lease Owner Champlin Refining Company
Lease Name Parks Well No. 1
Office Address P.O. Dr. #552, Enid, Oklahoma
Character of Well (completed as Oil, Gas or Dry Hole) Dry Hole
Date well completed July 9, 19 54
Application for plugging filed July 9, 19 54
Application for plugging approved July 9, (Verbal) 19 54
Plugging commenced July 10, 19 54
Plugging completed July 10, 19 54
Reason for abandonment of well or producing formation

If a producing well is abandoned, date of last production 19
Was permission obtained from the Conservation Division or its agents before plugging was commenced? Yes

Name of Conservation Agent who supervised plugging of this well Mr. M. A. Rives
Producing formation Depth to top Bottom Total Depth of Well 3937' Feet
Show depth and thickness of all water, oil and gas formations.

OIL, GAS OR WATER RECORDS

CASING RECORD

FORMATION	CONTENT	FROM	TO	SIZE	PUT IN	PULLED OUT
				8 5/8" OD	229	None

Describe in detail the manner in which the well was plugged, indicating where the mud fluid was placed and the method or methods used in introducing it into the hole. If cement or other plugs were used, state the character of same and depth placed, from feet to feet for each plug set.

Filled hole with heavy rotary mud from 3937' T.D. to 220', set Halliburton plug at 220' using small amount of hulls ahead of plug and then set cement plug using 20 sacks, then filled hole with heavy mud from top of cement to 35' from bottom of cellar and used Halliburton plug and 1/4 sack of hulls and 10 sacks of cement filling hole to bottom of cellar.

Used Halliburton to plug well.

RECEIVED 7-12-54
STATE CORPORATION COMMISSION
JUL 12 1954
CONSERVATION DIVISION
Wichita, Kansas

(If additional description is necessary, use BACK of this sheet)
Name of Plugging Contractor Garvey Drlg. Co.
Address Great Bend, Kansas

STATE OF Kansas, COUNTY OF Barton, ss.
J. W. Meyers (employee of owner) or (owner or operator) of the above-described well, being first duly sworn on oath, says: That I have knowledge of the facts, statements, and matters herein contained and the log of the above-described well as filed and that the same are true and correct. So help me God.

(Signature) J. W. Meyers
P.O. Box 167, Ellipton, Kansas (Address)

SUBSCRIBED AND SWORN TO before me this 10th day of July 19 54

N. Kenneth Steiner Notary Public.

My commission expires Sept. 10, 1955

24-2675-3 2-52-20M
PLUGGING
FILE SEC 2 T 23 R 14W
BOOK PAGE 47 LINE 36

15-185-00966-0000

STATE CORPORATION COMMISSION
Conservation Division
600 Bittling Building
Wichita, Kansas

COUNTY Stafford SEC. 2 TWP. 23S RGE. 14W

COMPANY OPERATING Champlin Refining Company

OFFICE ADDRESS Box 552 - Enid, Oklahoma

FARM NAME Parks WELL NO. 1

WELL LOCATED NW/4 NE/4 NE/4 Section 2-23S-14W or

330' from North line and 990' from East line NE/4

CHARACTER OF WELL Dry hole

DRILLING COMMENCED June 28, 1954

DRILLING COMPLETED July 9, 1954

SIZE	WEIGHT	TYPE	MAKE	FT.	AMOUNT PULLED	CEMENT
8-5/8"	24#	8 rd	National	232.67	None	200 sacks

FORMATION RECORD

	TOPS	BOTTOM	TOPS	BOTTOM
			Elevation: 1941' D.F.	
Lime	0	229		
Shale-Red Bed	229	307	Geological Topst	
Sand	207	363		
Red Bed	363	853	Heebner	3357
Anhydrite	853	880	Bron Lime	3487
Shale-Shells	880	1685	Lansing	3503
Shale-Lime	1685	3220	Base Kansas City	3726
Lime	3220	3232	Viola	3863
Shale-Lime	3232	3505	Simpson	3906
Lime	3505	3798	Arbuckle	
Viola	3798	3862		
Simpson	3862	3907		
Arbuckle	3907	3937 T.D.		

RECEIVED
STATE CORPORATION COMMISSION
JUL 15 1954
CONSERVATION DIVISION
Wichita, Kansas

J. G. Wentworth
Superintendent

Don Price
Notary Public

Subscribed and sworn to before me
this 14 day of July, 1954

My Commission expires August 14, 1954