

15-185-01416-0000

STATE OF KANSAS
STATE CORPORATION COMMISSION


Form CP-4

WELL PLUGGING RECORD

All Information Completely
Required Affidavit
or Deliver Report to:
Conservation Division
State Corporation Commission
211 No. Broadway
Wichita, Kansas

Stafford County, Sec. 4 Twp. 23S Rge. 14W (E) (W)
Location as "NE/CNW/SW" or footage from lines SE SE SE
Lease Owner Kansas Exploration Company
Lease Name Prescott Well No. 1
Office Address 232 Bonnie Brae, Wichita, Kansas
Character of Well (completed as Oil, Gas or Dry Hole) Dry Hole
Date well completed 3-15-63 19
Application for plugging filed 3-15-63 19
Application for plugging approved 3-15-63 19
Plugging commenced 3-15-63 19
Plugging completed 3-15-63 19
Reason for abandonment of well or producing formation Dry Hole

NORTH

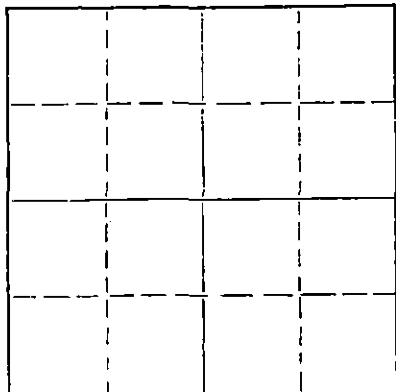

Locate well correctly on above
Section Plat

Name of Conservation Agent who supervised plugging of this well Herman Justus, Nickerson, Kansas
Producing formation _____ Depth to top _____ Bottom _____ Total Depth of Well 4045 Feet
Show depth and thickness of all water, oil and gas formations.

OIL, GAS OR WATER RECORDS

CASING RECORD

FORMATION	CONTENT	FROM	TO	SIZE	PUT IN	PULLED OUT
				8 5/8"	254'	none

Describe in detail the manner in which the well was plugged, indicating where the mud fluid was placed and the method or methods used in introducing it into the hole. If cement or other plugs were used, state the character of same and depth placed, from _____ feet to _____ feet for each plug set.

Mud to 180' & plug with 1/4 sack of hulls and 20 sacks cement
Mud to 40' with plug of 1/4 sack of hulls and 10 sacks cement
2 sacks cement in rat hole

RECEIVED
STATE CORPORATION COMMISSION

3-20-63

MAR 20 1963

(If additional description is necessary, use BACK of this sheet)
Name of Plugging Contractor Leben Drilling, Inc.
Address P. O. Box 486, Great Bend, Kansas
Wichita, Kansas

STATE OF KANSAS, COUNTY OF BARTON, ss.
Leslie Kite (employee of owner) or (owner or operator) of the above-described well, being first duly sworn on oath, says: That I have knowledge of the facts, statements, and matters herein contained and the log of the above-described well as filed and that the same are true and correct. So help me God.

(Signature) Leslie Kite
P. O. Box 486, Great Bend, Kansas
(Address)

SUBSCRIBED AND SWORN TO before me this 19th day of March, 1963

My commission expires April 1, 1963

Ulanda Nichols
Notary Public.

INVOICED

DATE 3/20/63
INV. NO. 6960-14

15-185-01416-0000

DRILLER'S LOG

COMPANY: Kansas Exploration Company
 CONTRACTOR: LEBEN DRILLING, INC.
 FARM: PRESCOTT #1
 LOCATION: SE SE SE Sec. 4-23S-14W
 STAFFORD COUNTY, KANSAS
 COMMENCED: 3-5-63
 COMPLETED: 3-15-63

0	135	Sand
135	254	Shale
254	400	Sand
400	845	Red Rock
845	890	Anhydrite
890	1700	Shale
1700	1800	Shale & Lime
1800	2320	Lime
2320	3240	Lime & Shale
3240	3411	Lime
3411	3538	Lime & Shale
3538	3898	Lime
3898	3925	Lime & Chert
3925	3976	Chert & Lime
3976	3994	Lime
3994	4045	Arbuckle
	<u>4045</u>	<u>Rotary Total Depth - D. & A.</u>

RECEIVED
STATE CORPORATION COMMISSION

MAR 20 1963

NOTARY PUBLIC
Wichita, Kansas

Set 8 5/8" used casing @ 254' Cemented with 275 sacks Sunset with 1/2# flo seal per sack.

I, Leslie Kite, do hereby certify that the above and foregoing is a true and correct copy of the log of the Prescott #1, located SE SE SE of Section 4, Township 23 South, Range 14 West, Stafford County, Kansas, as reflected by the files of Leben Drilling, Inc.

Leslie Kite

Leslie Kite

STATE OF KANSAS)
) SS
COUNTY OF BARTON)

Subscribed and sworn to before me, a Notary Public, in and for Barton County, Kansas, this 19th day of March, 1963.

Ulanda Nichols

Ulanda Nichols, Notary Public

My Commission Expires:
April 1, 1963