


STATE OF KANSAS  
STATE CORPORATION COMMISSION

Form CP-49

Give All Information Completely  
Make Required Affidavit  
Mail or Delivery Report to:  
Conservation Division  
State Corporation Commission  
211 No. Broadway  
Wichita, Kansas

## WELL PLUGGING RECORD

NORTH

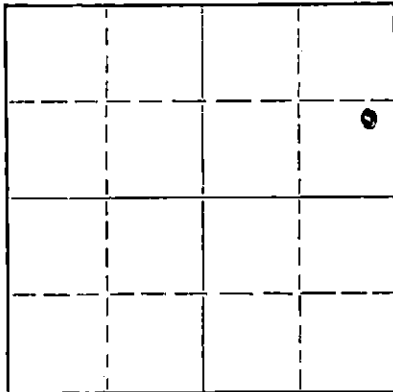

Locate well correctly on above  
Section Plat

Harvey County. Sec. 18 Twp. 22 Rge. 3 (E) W (W)  
Location as "NE/CNW/SW" or footage from lines NE-SE-NE  
Lease Owner Aladdin Petroleum Corporation  
Lease Name Neufeldt Well No. 10  
Office Address Petroleum Building, Wichita 2, Kansas  
Character of Well (completed as Oil, Gas or Dry Hole) Dry Hole  
Date well completed 7-29-63 19  
Application for plugging filed 7-29-63 19  
Application for plugging approved 7-29-63 19  
Plugging commenced 7-20-63 19  
Plugging completed 7-29-63 19  
Reason for abandonment of well or producing formation Dry Hole

If a producing well is abandoned, date of last production 19  
Was permission obtained from the Conservation Division or its agents before plugging was commenced? Yes

Name of Conservation Agent who supervised plugging of this well Cecil Jones

Producing formation \_\_\_\_\_ Depth to top \_\_\_\_\_ Bottom \_\_\_\_\_ Total Depth of Well \_\_\_\_\_ Feet

Show depth and thickness of all water, oil and gas formations.

## OIL, GAS OR WATER RECORDS

## CASING RECORD

| FORMATION | CONTENT | FROM | TO | SIZE | PUT IN | PULLED OUT |
|-----------|---------|------|----|------|--------|------------|
|           |         |      |    |      |        |            |
|           |         |      |    |      |        |            |
Describe in detail the manner in which the well was plugged, indicating where the mud fluid was placed and the method or methods used in introducing it into the hole. If cement or other plugs were used, state the character of same and depth placed, from 1770 feet to 305 feet for each plug set.

Mud from total depth to 305 ft.-Bridge with Halls and rocks, etc., and 40 sacks cement thru drill pipe-mud to 30 ft. and 10 sacks cement.

RECEIVED  
STATE CORPORATION COMMISSION

AUG 5 1963

CONSERVATION DIVISION  
Wichita, Kansas

(If additional description is necessary, use BACK of this sheet)

Name of Plugging Contractor German drilling Company  
Address 502 Petroleum Building, Wichita 2, Kansas

STATE OF Kansas, COUNTY OF Butler, ss.

Harvey F. German (employee of owner) or (owner or operator) of the above-described well, being first duly sworn on oath, says: That I have knowledge of the facts, statements, and matters herein contained and the log of the above-described well as filed and that the same are true and correct. So help me God.

(Signature)

Harvey F. German  
502 Petroleum Building, Wichita 2, Kansas  
(Address)

SUBSCRIBED AND SWORN TO before me this 31st day of July, 1963.

My commission expires December 29th, 1963.

Geneva M. German  
Notary Public.