

STATE OF KANSAS  
STATE CORPORATION COMMISSION


Form CP-4

Give All Information Completely  
Make Required Affidavit  
Mail or Deliver Report to:  
Conservation Division  
State Corporation Commission  
211 No. Broadway  
Wichita, Kansas

WELL PLUGGING RECORD

GP

NORTH

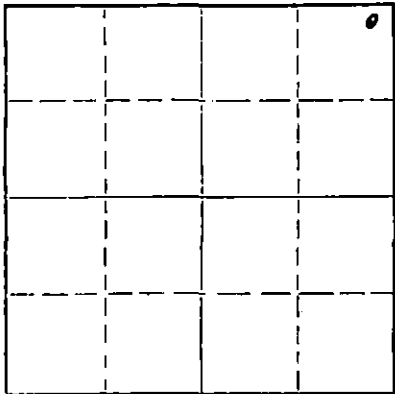

Locate well correctly on above  
Section Plat

Harvey County, Sec. 18 Twp. 22 Rge. 3 (E) W (W)  
Location as "NE/CNW/SW" or footage from lines. NE NE NE  
Lease Owner. Aladdin Petroleum Corporation  
Lease Name. Neufeldt Well No. 7  
Office Address. Petroleum Building, Wichita 2, Kansas  
Character of Well (completed as Oil, Gas or Dry Hole) Dry Hole  
Date well completed 5-28-63 19  
Application for plugging filed 5-28-63 19  
Application for plugging approved 5-28-63 19  
Plugging commenced 5-28-63 19  
Plugging completed 5-28-63 19  
Reason for abandonment of well or producing formation Dry Hole

If a producing well is abandoned, date of last production None 19  
Was permission obtained from the Conservation Division or its agents before plugging was commenced? Yes

Name of Conservation Agent who supervised plugging of this well Cecil Jones, McPherson, Kansas  
Producing formation Depth to top Bottom Total Depth of Well 2188 Feet  
Show depth and thickness of all water, oil and gas formations.

OIL, GAS OR WATER RECORDS

CASING RECORD

FORMATION	CONTENT	FROM	TO	SIZE	PUT IN	PULLED OUT

Describe in detail the manner in which the well was plugged, indicating where the mud fluid was placed and the method or methods used in introducing it into the hole. If cement or other plugs were used, state the character of same and depth placed, from 2056 feet to 200 feet for each plug set.  
Mud from 2056 feet to 200 ft. plug and 20 ft. of rock bridge and filled up ready mix concrete to bottom of cellar.

6-4-63

RECEIVED  
STATE CORPORATION COMMISSION

JUN 4 1963

CONSERVATION DIVISION  
Wichita, Kansas

(If additional description is necessary, use BACK of this sheet)

Name of Plugging Contractor German Drilling Company  
Address Petroleum Building, Wichita 2, Kansas

STATE OF Kansas, COUNTY OF Butler, ss.  
Harvey F. German (employee of owner) or (owner or operator) of the above-described well, being first duly sworn on oath, says: That I have knowledge of the facts, statements, and matters herein contained and the log of the above-described well as filed and that the same are true and correct. So help me God.

(Signature) Harvey F. German  
Petroleum Building, Wichita, 2, Kansas  
(Address)

SUBSCRIBED AND SWORN TO before me this 28th day of May, 1963

My commission expires December 29th, 1963.

Geneva M. German

Notary Public.