

State

15-079-00841-0000

STATE OF KANSAS
STATE CORPORATION COMMISSION
Give All Information Completely
Make Required Affidavit
Mail or Deliver Report to:
Conservation Division
State Corporation Commission
800 Blitting Building
Wichita, Kansas


WELL PLUGGING RECORD

OR

~~FORMATION PLUGGING RECORD~~

Strike out upper line
when reporting plug-
ging off formations.

NORTH

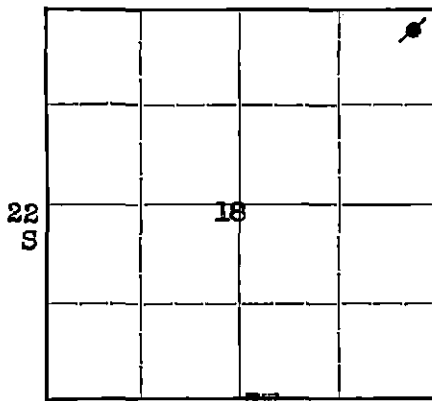

Locate well correctly on above
Section Plat

Harvey County. Sec. 18 Twp. 22S Rge. 3 (W)
Location as "NE $\frac{1}{4}$ NW $\frac{1}{4}$ SW $\frac{1}{4}$ " or footage from lines E/2 NE $\frac{1}{4}$, 328' fm Nth line
Lease Owner Sinclair Prairie Oil Co 327' fm East line
Lease Name John Neufeld-B # 1 Well No. 1
Office Address PO Box 521 Tulsa, Okla.
Character of Well (completed as Oil, Gas or Dry Hole) Oil
Date, well completed Aug. 3 1933
Application for plugging filed June 28 1941
Application for plugging approved July 2 1941
Plugging Commenced Sept. 12 1941
Plugging Completed Sept. 18 1941
Reason for abandonment of well or producing formation dry

If a producing well is abandoned, date of last production Jan. 7 1941
Was permission obtained from the Conservation Division or its agents before plugging was com-
menced? yes

Name of Conservation Agent who supervised plugging of this well Ruel Durkee
Producing formation Arbuckle Depth to top 3604 Bottom Total Depth of Well 3608 $\frac{1}{2}$ Feet
Show depth and thickness of all water, oil and gas formations.


OIL, GAS OR WATER RECORDS

CASING RECORD

Formation	Content	From	To	Size	Put In	Pulled Out
Wilcox Sand	dry	3339	3385	15 $\frac{1}{2}$ "	327'	0
Arbuckle lime	dry	3604	3608 $\frac{1}{2}$	8" 7"	3121' 3339'	2050' 3294'

Describe in detail the manner in which the well was plugged, indicating where the mud fluid was placed and the method or methods used in
introducing it into the hole. If cement or other plugs were used, state the character of same and depth placed, from.....feet to
.....feet for each plug set.

3608 $\frac{1}{2}$ - 3592 cement
3592 - 3339 mud
3339 - 3309 cement
3309 - 3121 mud
3121 - 3100 cement
3100 - 200 mud
200 - 180 cement
180 - 10 mud
10 - 0 cement

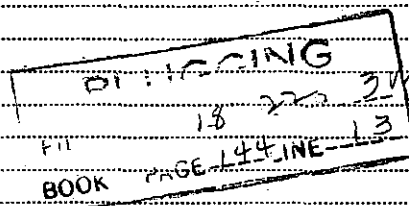

9-22-41

(If additional description is necessary, use BACK of this sheet)

Correspondence regarding this well should be addressed to Victor Chancellor
Address 1319-1/2 Main, Great Bend, Kans

STATE OF Kansas, COUNTY OF Barton, ss.
Victor Chancellor (employee of owner) or (owner or operator) of the above-described well,
being first duly sworn on oath, says: That I have knowledge of the facts, statements, and matters herein contained and the log of the above-
described well as filed and that the same are true and correct. So help me God.

(Signature) Victor Chancellor

(Address)

SUBSCRIBED AND SWORN to before me this 20th day of September, 1941.

My commission expires 6-14-43 Notary Public.

Well Log

15-079-00841-0000

Sinclair Prairie Oil Company
 John Neufeldt "B" # 1. (One)
 328' fm. N.E. & 327' fm. E.L.
 E/2 - NE/4 Sec. 18-22S-3W
 Harvey County, Kansas

<u>Formation</u>	<u>Thickness</u>	<u>Total Depth</u>
Soil	12	12
Sand	13	25
Sandy Shale	55	80
Sand & Shells	94	174
Shale and Shells	142	316
Shale and Shells	484	800
Shale and Lime	810	1610
Shale and Shells	233	1843
Shale	127	1970
Shale and Shells	65	2035
Shale	115	2150
Sandy Lime and Shale	20	2170
Lime and Shale	40	2210
Shale and Shells	115	2325
Shale	65	2390
Hard Lime and Shale	60	2450 ^{KL}
Lime	67	2517
Lime and Shale	188	2705
Lime	100	2805
Shale	10	2815
Lime and Shale	80	2895
Shale	55	2950
Lime	20	2970
Lime and Shale	120	3090
Shale	31	3121 ^M
Chat	41	3162
Chat and Lime	38	3200
Lime - Brown	32	3232
Dolomite	6	3238
Shale	100	3338
Sand	1	3339 ^K
Hutton Lime	21	3360
Dolomite	74	3434
Shale	59	3493
Viola Lime	25	3518
Green Shale	1	3519
Wilcox Sand	25	3544 T.D.

Deepened from 3544' to 3608 $\frac{1}{2}$ ' in Arbuckle Lime.

Present Total Depth 3608 $\frac{1}{2}$ '

PLUGGING	
FILE	18-22S-3W
BOOK	144 LINE-13

