


STATE OF KANSAS
STATE CORPORATION COMMISSION

Give All Information Completely
Make Required Affidavit
Mail or Deliver Report to:
Conservation Division
State Corporation Commission
800 Bittig Building
Wichita, Kansas

WELL PLUGGING RECORD

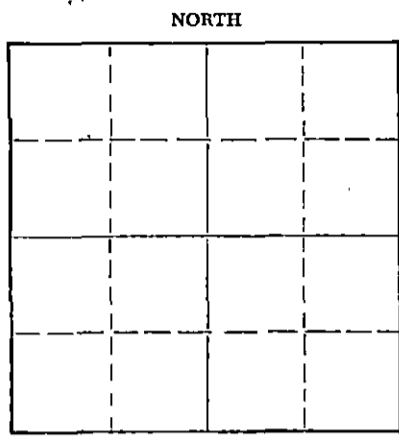

Locate well correctly on above
Section Flat

Stafford County, Sec. 9 Twp. 22 Rge. 13 (E) 13 (W)
Location as "NE/CNW/SW" or footage from lines SW NW NE
Lease Owner Petroleum, Inc.
Lease Name KELLEY Well No. 1
Office Address 311 East Third, Wichita, Kansas
Character of Well (completed as Oil, Gas or Dry Hole) Dry Hole
Date well completed February 23, 1956
Application for plugging filed February 23, 1956
Application for plugging approved February 23, 1956
Plugging commenced February 23, 1956
Plugging completed February 23, 1956
Reason for abandonment of well or producing formation
Dry Hole

If a producing well is abandoned, date of last production 19
Was permission obtained from the Conservation Division or its agents before plugging was commenced? yes

Name of Conservation Agent who supervised plugging of this well Mr. M. A. Rives
Producing formation Depth to top Bottom Total Depth of Well 3797' Feet
Show depth and thickness of all water, oil and gas formations.

OIL, GAS OR WATER RECORDS

CASING RECORD

FORMATION	CONTENT	FROM	TO	SIZE	PUT IN	PULLED OUT
				8-5/8"	280'	None

Describe in detail the manner in which the well was plugged, indicating where the mud fluid was placed and the method or methods used in introducing it into the hole. If cement or other plugs were used, state the character of same and depth placed, from feet to feet for each plug set.

Mudded up to 270', and set wooden plug preceded by 1/3 sack hulls. Displaced 20 sacks cement through drill pipe onto plug and mudded up to 25'. Set second wooden plug at 25' preceded by 1/3 sack hulls and filled hole to base of well cellar with 10 sacks cement.

(If additional description is necessary, use BACK of this sheet)

Name of Plugging Contractor Garvey Drilling Company
Address R. R. #2 - Great Bend, Kansas

STATE OF KANSAS, COUNTY OF SEDGWICK, ss.
Karl E. Becker (employee of owner) or (owner or operator) of the above-described well, being first duly sworn on oath, says: That I have knowledge of the facts, statements, and matters herein contained and the log of the above-described well as filed and that the same are true and correct. So help me God.

(Signature)

Karl E. Becker
311 East Third, Wichita, Kansas
(Address)

SUBSCRIBED AND SWORN TO before me this 24th day of February, 1956

Frances Sloan

Notary Public.

My commission expires September 2, 1959

FRANCES SLOAN, Notary Public
My Commission expires Sept. 2, 1959

CONSERVATION DIVISION
Wichita, Kansas
3-7-56

PLUGGING
FILE SEC 9 T 22 R 13W
BOOK PAGE 41 LINE 21

WELL LOG

15.185-00326-0000

COMPANY **Petroleum, Inc.**

SEC. **9** T. **22S** R. **13W**

FARM **KELLEY** NO. **1**


LOC. **SW NW NE**
990' FNL
2390' FEL

TOTAL DEPTH **3797'**

COUNTY **Stafford**

COMM. **February 14, 1956** COMP. **February 23, 1956**

CONTRACTOR **Carvey Drilling Company**

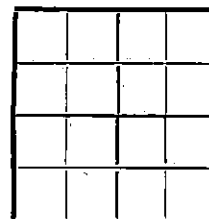

CASING **8-5/8" @ 260' w/225 sax**

ELEVATION **1895' DP**
1897' RB

PRODUCTION **D & A**

FIGURES INDICATE BOTTOM OF FORMATIONS

40	Surface Soil & Sand
255	Sand, Shells & Clay
281	Blue Shale
300	Red Bed
825	Red Bed, Shale & Sand
1215	Red Bed & Shale
1500	Shale & Shells
3393	Lime & Shale
3452	Lime
3572	Lime & Shale
3728	Lime
3765	Lime, Shale & Chert
3797	Arbuckle

Sample Tops

Heebner	3252 (-1355)
Brn Lime	3380 (-1483)
K C	3397 (-1500)
Conglomerate	3652 (-1755)
Viola	3670 (-1773)
Simpson	3734 (-1837)
Arbuckle	3784 (-1887)

RTD 3797'

State of KANSAS } ss:
County of SEDGWICK

PLUGGING
FILE SEC 9 T 22 R 13W
BOOK PAGE 41 LINE 21

I, Karl E. Becker of Petroleum, Inc.

upon oath state that the above and foregoing is a true and correct copy of the log of the KELLEY #1 well

Subscribed and sworn to before me this 29th day of February 19 56

My Commission Expires: September 2, 1959

Frances Sloan
NOTARY PUBLIC

FRANCES SLOAN, Notary Public
My Commission expires Sept. 2, 1959