


STATE OF KANSAS
STATE CORPORATION COMMISSION

Form CP-4

WELL PLUGGING RECORD

Give All Information Completely
Make Required Affidavit
Mail or Deliver Report to:
Conservation Division
State Corporation Commission
212 No. Market
Wichita, Kansas

NORTH

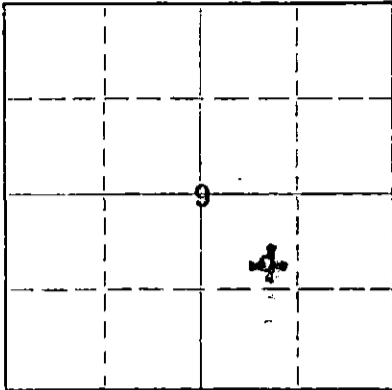

Locate well correctly on above
Section Plat

Stafford County, Sec. **9** Twp. **22S** Rge. **13W** ~~EX~~ (W)

Location as "NE/CNWxSWx" or footage from lines **SE NW SE**

Lease Owner **D. R. Lauck Oil Company, Inc.**

Lease Name **Keller** Well No. **1**

Office Address **301 S. Broadway, Wichita, Kansas**

Character of Well (completed as Oil, Gas or Dry Hole) **Dry Hole**

Date well completed **November 18, 1966**

Application for plugging filed **November 18, 1966**

Application for plugging approved **November 18, 1966**

Plugging commenced **November 18, 1966**

Plugging completed **November 18, 1966**

Reason for abandonment of well or producing formation **Dry Hole**

If a producing well is abandoned, date of last production _____ 19____

Was permission obtained from the Conservation Division or its agents before plugging was commenced? **Yes**

Name of Conservation Agent who supervised plugging of this well **Archie Elving**

Producing formation _____ Depth to top _____ Bottom _____ Total Depth of Well **3851** Feet

Show depth and thickness of all water, oil and gas formations.

OIL, GAS OR WATER RECORDS

CASING RECORD

FORMATION	CONTENT	FROM	TO	SIZE	PUT IN	PULLED OUT
		0'	263'	8-5/8"	263'	None

Describe in detail the manner in which the well was plugged, indicating where the mud fluid was placed and the method or methods used in introducing it into the hole. If cement or other plugs were used, state the character of same and depth placed, from _____ feet to _____ feet for each plug set.

3851'-240' Mud
 240'-236' Plug
 236'-196' Cement, 25 sacks
 196'-40' Mud
 40'-36' Plug
 36'-6' Cement, 10 sacks (Bottom of cellar)

11-23-66
 RECEIVED
 NOV 23 1966
 CONSERVATION DIVISION
 WICHITA, KANSAS

(If additional description is necessary, use BACK of this sheet)

Name of Plugging Contractor **Lauck Drilling Company, Incorporated**
Address **Wichita, Kansas**

STATE OF **KANSAS**, COUNTY OF **SEDGWICK**, ss.

John H. Knightley

(employee of owner) or (owner or operator) of the above-described

well, being first duly sworn on oath, says: That I have knowledge of the facts, statements, and matters herein contained and the log of the above-described well as filed and that the same are true and correct. So help me God.

(Signature)

John H. Knightley
301 S. Broadway, Wichita, Kansas
(Address)

SUBSCRIBED AND SWORN TO before me this **22nd** day of **November**, 19**66**

My commission expires **March 12, 1967**

Stella J. Lipp

Notary Public.

D. R. Lauck Oil Company, Inc.

Keller #1

SE NW SE Sec. 9-22S-13W
Stafford County, Kansas

Commenced: November 10, 1966
Completed: November 18, 1966

Casing Record: 263' 8-5/8" Cemented with 220 sacks Cement,
5 sacks Calcium Chloride.

Elevation: GL 1893; DF 1895; KB 1897.

RECEIVED
STATE CORPORATION COMMISSION
NOV 28 1966
CONSERVATION DIVISION
Topeka, Kansas

Drillers Log

Tops

Sand	185
Shale	205
Sand	245
Shale	263
Shale, Shells, Redbed	752
Anhydrite	765
Shale & Shell	855
Shale & Shells	1465
Shale	1565
Shale & Lime	1851
Lime with Shale Streaks	2080
Lime & Shale	2140
Shale & Lime	2475
Shale w/Lime Streaks	2685
Shale & Lime	3005
Lime	3160
Lime, Cherty	3247
Lime & Shale	3302
Shale	3390
Lime	3670
Lime & Shale	3725
Chert	3760
Lime & Shale	3809
Dolomite	3851 RTD

Anhydrite	745+1152
Heebner	3266-1369
Brown Lime	3395-1498
Lansing	3414-1517
Conglomerate	3698-1801
Viola	3718-1821
Simpson Shale	3768-1871
Arbuckle	3809-1912
Total Depth	3851-1954

DST #1 (S) 3540-85, open 30, shut in 30, open 30, shut in 30 minutes. Weak blow 1 hour. Recovered 80' muddy water. ISIP 989#. IFP 33#. FFP 83#. FSIP 973#.

DST #2 (S) 3592-3610, open 30, shut in 30, open 30, shut in 30 minutes. Weak blow 15 minutes, weak intermittent blow 15 minutes & died. Recovered 30' mud. ISIP 922#. IFP 25#. FFP 25#. FSIP 704#.

D&A