

STATE OF KANSAS  
STATE CORPORATION COMMISSION


WELL PLUGGING RECORD

Give All Information Completely  
Make Required Affidavit  
Mail or Deliver Report to:  
Conservation Division  
State Corporation Commission  
800 Bitting Building  
Wichita, Kansas

Stafford County. Sec. 9 Twp. 22 Rge. (E) 13 (W)

Location as "NE/CNW/SW" or footage from lines SE NE SE  
Lease Owner Chas. Hulme Drilling Contractor  
Lease Name Charlie Keller Well No. 1  
Office Address Box 36, Great Bend, Kansas  
Character of Well (completed as Oil, Gas or Dry Hole) Dry Hole  
Date well completed December 28 19 53  
Application for plugging filed December 28 19 53  
Application for plugging approved December 28 19 53  
Plugging commenced December 28 19 53  
Plugging completed December 28 19 53  
Reason for abandonment of well or producing formation Dry Hole

NORTH

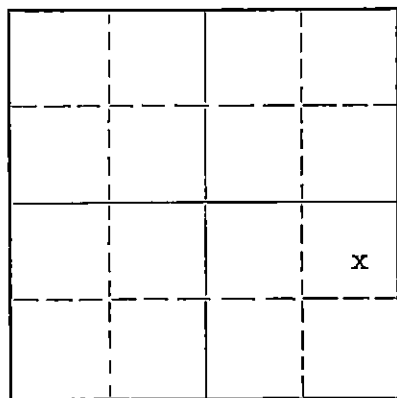

Locate well correctly on above  
Section Plat

If a producing well is abandoned, date of last production 19  
Was permission obtained from the Conservation Division or its agents before plugging was commenced? Yes

Name of Conservation Agent who supervised plugging of this well Mr. M. A. Rives  
Producing formation Depth to top Bottom Total Depth of Well Feet  
Show depth and thickness of all water, oil and gas formations.

OIL, GAS OR WATER RECORDS

CASING RECORD

FORMATION	CONTENT	FROM	TO	SIZE	PUT IN	PULLED OUT

Describe in detail the manner in which the well was plugged, indicating where the mud fluid was placed and the method or methods used in introducing it into the hole. If cement or other plugs were used, state the character of same and depth placed, from feet to feet for each plug set.

Cement from 270 feet to 210 feet;

Mud from 210 feet to 45 feet;

Cement from 45 feet to ground level.

1-7-54

(If additional description is necessary, use BACK of this sheet)

Name of Plugging Contractor Chas. Hulme Drilling Contractor  
Address Box 36, Great Bend, Kansas

STATE OF Kansas, COUNTY OF Barton, ss.  
C. E. Byars (employee of owner) or (owner or operator) of the above-described well, being first duly sworn on oath, says: That I have knowledge of the facts, statements, and matters herein contained and the log of the above-described well as filed and that the same are true and correct. So help me God.

(Signature) C. E. Byars  
Great Bend, Kansas (Address)

SUBSCRIBED AND SWORN TO before me this 6 day of January, 19 54

My commission expires October 15, 1957 Notary Public.

PLUGGING  

DRILLER'S LOG

Charlie Keller #1  
 Commenced R.D.: 12-15-53  
 Completed R. D.: 12-28-53  
 Total Depth: 3820 Ft.  
 Casing Record: 300 Ft. 8 5/8"

SE, NE SE, Sec. 9-22-13W  
 Stafford County, Kansas  
 Elevation: 1897 D.F.  
 Contractor: Chas. Hulme Drlg. Contr.

Sand.	0	18
Sand and Red Bed	108	300
Red Bed and Shale	300	766
Anhydrite	766	800
Shale and Shells	800	1630
Lime	1630	2015
Shale and Lime	2015	2160
Lime	2160	2250
Lime and Shale	2250	3020
Lime	3020	3320
Shale	3320	3350
Shale and Lime	3350	3412
Lime	3412	3638
Conglomerate	3638	3685
Lime and Chert	3685	3747
Chert and Shale	3747	3769
Shale	3769	3820
TD	3820	

I hereby certify the above a true and correct drilling log as reflected by the drilling reports of the Chas. Hulme Drilling Company.

CHAS. HULME DRILLING CONTRACTOR

*C. E. Byars*  
 C. E. Byars

Signed and sworn to in my presence this 6th day of January, 1954, by C. E. Byars, General Manager of the Chas. Hulme Drilling Company.

*Fay Johnson*  
 Notary Public

My commission expires October 15, 1957.

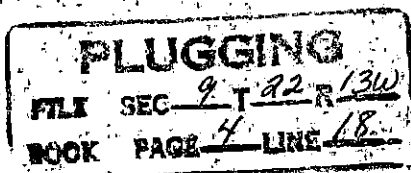









