


WELL PLUGGING RECORD

Give All Information Completely
Miser Required Affidavit
Mail or Deliver Report to:
Conservation Division
State Corporation Commission
800 Bittling Building
Wichita, Kansas

NORTH

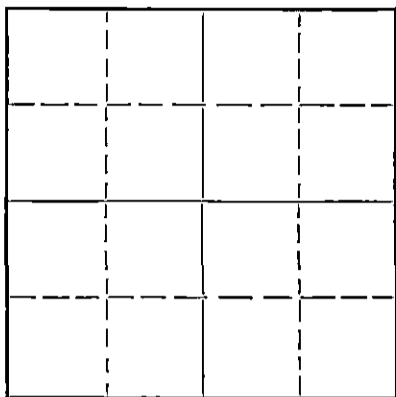

Locate well correctly on above
Section Plat

Stafford County, Sec. 1 Twp. 22 Rge. 12 (W)
Location as "NE/CNW $\frac{1}{4}$ SW $\frac{1}{4}$ " or footage from lines SW SE SW
Lease Owner D. M. Shawver & W. L. Graham
Lease Name Helmers Well No.
Office Address 504 Fourth Nat'l Bank, Wichita, Kansas
Character of Well (completed as Oil, Gas or Dry Hole) Dry Hole
Date well completed 12/8 19 50
Application for plugging filed 12/7 19 50
Application for plugging approved 12/7 19 50
Plugging commenced 12/8 19 50
Plugging completed 12/8 19 50
Reason for abandonment of well or producing formation Dry hole

If a producing well is abandoned, date of last production 19
Was permission obtained from the Conservation Division or its agents before plugging was commenced? yes

Name of Conservation Agent who supervised plugging of this well C. D. Stough
Producing formation Arbuckle Depth to top 3630 Bottom 3635 Total Depth of Well 3635 Feet
Show depth and thickness of all water, oil and gas formations.

OIL, GAS OR WATER RECORDS

CASING RECORD

Formation	Content	From	To	Size	Put In	Pulled Out
Lime & Shale		surface	3261	8 5/8"	192'	none
Lansing KC		3261	3530			
Viola		3530	3574			
Simpson		3574	3630			
Arbuckle		3630	TD			

Describe in detail the manner in which the well was plugged, indicating where the mud fluid was placed and the method or methods used in introducing it into the hole. If cement or other plugs were used, state the character of same and depth placed, from feet to feet for each plug set.

Filled Hole with heavy mud, set first plug at 190'. Poured 15 sx cement thru drill pipe
Set 2nd Plug at 30'. filled hole w/ 10 Sx Cement.

RECEIVED
STATE CORPORATION COMMISSION
DEC 13 1950
CONSERVATION DIVISION
Wichita, Kansas
12-13-50

(If additional description is necessary, use BACK of this sheet)

Correspondence regarding this well should be addressed to Laura Jane Oil Co., Inc.
Address 504 Fourth National Bank
Wichita, Kans

STATE OF Kansas, COUNTY OF Sedgwick, ss.
H. D. Shawver (employee, owner or operator) of the above-described well,
being first duly sworn on oath, says: That I have knowledge of the facts, statements, and matters herein contained and the log of the above-described well as filed and that the same are true and correct. So help me God.

(Signature) H. D. Shawver
504 Fourth National Bank, Wichita, Kans
(Address)

SUBSCRIBED AND SWORN to before me this 12th day of December 12, 19 50

Coral F Jais
Notary Public

My commission expires 6/28/52

PLUGGING
FILE SEC 1-T-22-R-126
BOOK PAGE 48 LINE 1

DRILLING LOG

WELL NAME: Helmers # 3
 OWNERS: Laura Lane Oil Co.
 CONTRACTORS: Laura Jane Oil Co.
 COMM: 11-28-50
 COMP: 12-7-50

LOCATION: SW SE SW, 1-22S-12W
 Stafford County, Kans.
 ELEVATION: 1824 DF
 1821 Gr
 CASING RECORD: 8 5/8" @ 192'
 PRODUCTION: Dry Hole

<u>FORMATION</u>	<u>TO</u>	
Sand & Soil	75	
Shale	192	
Shale-Red Rock	455	
Anhydrite	480	
Shale-Shells	1401	
Shale-Lime	1650	
Lime	1905	
Lime-Shale	2550	
Lime-Broken	2695	
Lime-Shale	2930	
Sandy Lime	2970	
Lime-Shale	3255	
Lime	3450	
Shale-Lime	3520	
Lime	3551	
Lime-Chert	3573	
Lime	3635	TD Rotary

Tops

Lansing K.C.	3261
Viola	3530
Simpson	3574
Arbuckle	3630

I certify that the above is a true and correct copy of the log of the Helmers # 3, SW SE SW, 1-22S-12W, Stafford County, Kansas, to the best of my knowledge.

Laura Jane Oil Co., Inc.

BY: H. D. Shawver
 H. D. SHAWVER

Sworn and subscribed to before me this 12th day of December, 1950.

Carol F. Jais
 NOTARY PUBLIC

My Comm. Expires 6-28-52.

PLUGGING
 FILE SEC 1 T 22 R 12 W
 BOOK PAGE 42 LINE 1

RECEIVED
 STATE CORPORATION COMMISSION
 DEC 14 1950
 CONSERVATION DIVISION
 Wichita, Kansas