


WELL PLUGGING RECORD

Give All Information Completely
Make Required Affidavit
Mail or Deliver Report to:
Conservation Division
State Corporation Commission
800 Bittling Building
Wichita, Kansas

NORTH

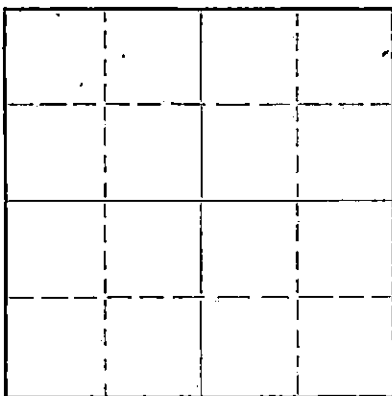

Locate well correctly on above Section Flat

Stafford County. Sec. 1 Twp. 22s. Rge. (E) 12 (W)
Location as "NE/CNW/SW" or footage from lines CW2 W2 NE1
Lease Owner A. S. Ritchie
Lease Name Mellies Well No. 1
Office Address 352 N. Broadway, Wichita, Kansas
Character of Well (completed as Oil, Gas or Dry Hole) Dry
Date well completed March 14 1950
Application for plugging filed March 14 1950
Application for plugging approved March 14 1950
Plugging commenced March 14 1950
Plugging completed March 14 1950
Reason for abandonment of well or producing formation Dry

If a producing well is abandoned, date of last production 19
Was permission obtained from the Conservation Division or its agents before plugging was commenced? Yes-In field

Name of Conservation Agent who supervised plugging of this well C. D. Stough
Producing formation Arbuckle Depth to top 3636 Bottom 3675 Total Depth of Well 3675 Feet
Show depth and thickness of all water, oil and gas formations.

OIL, GAS OR WATER RECORDS

CASING RECORD

Formation	Content	From	To	Size	Put In	Pulled Out
Sand-Red Shale	Water	0	250	8 5/8	250	None

Describe in detail the manner in which the well was plugged, indicating where the mud fluid was placed and the method or methods used in introducing it into the hole. If cement or other plugs were used, state the character of same and depth placed, from.....feet to.....feet for each plug set.

Filled with Heavy Mud 3675 to 245
Set plug - 15 Sax cement 245 to 200
Filled with Heavy Mud 200 to 45
Set wooden plug & 10 sax cement 45 to 6
Soil 6 to 0

3-23-50

MAR 23 1950

(If additional description is necessary, use BACK of this sheet)

Correspondence regarding this well should be addressed to A. S. Ritchie
Address 352 N. Broadway, Wichita, Kansas


STATE OF Kansas, COUNTY OF Sedgwick, ss.
Beulah Basham (employee of owner) or (owner or operator) of the above-described well,
being first duly sworn on oath, says: That I have knowledge of the facts, statements, and matters herein contained and the log of the above-described well as filed and that the same are true and correct. So help me God.

(Signature) Beulah Basham
Wichita, Kansas (Address)

SUBSCRIBED AND SWORN to before me this 22 day of March, 1950.

Deena Karnish
Notary Public.

My commission expires 12-18-53

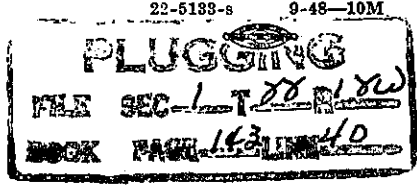

A. S. Ritchie
352 North Broadway
Wichita 2, Kansas

Mellies #1
CW $\frac{1}{2}$ W $\frac{1}{2}$ NE $\frac{1}{4}$, 1-22-12W
Stafford County, Kansas

Elevation: 1814 D.F.
Spudded: March 3, 1950
Rotary Tools Completed: March 14, 1950
Cable Tools Completed: None
Acid Treatment: None
Initial Production: D & A
Contractor: Derby Drilling Company

CASING RECORD

250' 8-5/8" O.D. 24# surface pipe cemented with 150 sacks ce-
5-1/2" ment.

DRILLERS LOG

Sand	0 to	120	Lime	1865 to	2100
Red shale		250	Shale & lime		2645
Red rock		280	Lime		3095
Shale & shells		1350	Lime & shale		3200
Shale & lime		1700	Lime		3545
Shale		1789	Chert, lime & shale		3569
Sand		1815	Shale		3623
Shale & shells		1865	Lime		3675 T.D.

3675 T D = 3673 D.F.

STATE OF KANSAS)
) SS
SEDGWICK COUNTY)

I hereby certify that to the best of my knowledge and belief, the foregoing log is true and correct.

DERBY DRILLING COMPANY

MAR 23 1950

S...
C... By M. S. Dada
KANSAS

Subscribed and sworn to before me, a Notary Public, in and for the State and County aforesaid this 21st day of March, 1950

PLUGGING
FILE SEC-1 T 22 R 12W
BOOK PAGE 143 LINE 40

Deena Larnish
Notary Public

My com. exp