


STATE OF KANSAS
STATE CORPORATION COMMISSION
Give All Information Completely
Make Required Affidavit
Mail or Deliver Report to:
Conservation Division
State Corporation Commission
211 No. Broadway
Wichita, Kansas

Form CP-4

WELL PLUGGING RECORD

Stafford County, Sec. 1 Twp. 22 Rge. 12 (E) (W)

Location as "NE/CNW/SE/SW" or footage from lines CW 1/2 NE NE
Lease Owner H. C. Bennett
Lease Name Mollies Well No. 1
Office Address 1212 Union National Bldg., Wichita, Kansas
Character of Well (completed as Oil, Gas or Dry Hole) oil well
Date well completed 8-21-48 19
Application for plugging filed 5-18-65 19
Application for plugging approved 5-19-65 19
Plugging commenced 5-19-65 19
Plugging completed 5-22-65 19
Reason for abandonment of well or producing formation depleted

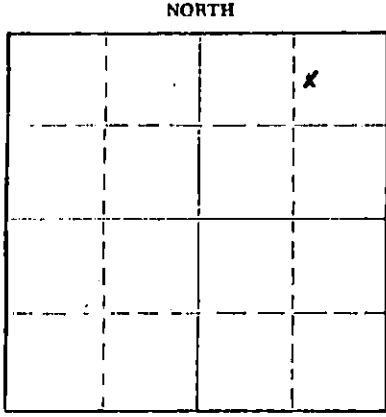

Locate well correctly on above Section Plat

If a producing well is abandoned, date of last production 19
Was permission obtained from the Conservation Division or its agents before plugging was commenced? yes

Name of Conservation Agent who supervised plugging of this well Archie Elving
Producing formation _____ Depth to top _____ Bottom _____ Total Depth of Well 3555 Feet
Show depth and thickness of all water, oil and gas formations.

OIL, GAS OR WATER RECORDS

CASING RECORD

FORMATION	CONTENT	FROM	TO	SIZE	PUT IN	PULLED OUT
				8 5/8	250	none
				5 1/2	3550	2416.21

Describe in detail the manner in which the well was plugged, indicating where the mud fluid was placed and the method or methods used in introducing it into the hole. If cement or other plugs were used, state the character of same and depth placed, from _____ feet to _____ feet for each plug set.

Set 25' rock bridge from 3275' to 3240' and dump 5 sacks cement.
Set 15' rock bridge from 245' to 230' and dump 5 sacks wet cement.
Let set overnight. Bailed hole dry to 225' and dump 20 sacks cement.
Mud hole to 40', set 10' rock bridge from 40' to 30' and dump 10 sacks cement.

6-1-65

RECEIVED
STATE CORPORATION COMMISSION

JUN 1 1965

CONSERVATION DIVISION
Wichita, Kansas

(If additional description is necessary, use BACK of this sheet)
Name of Plugging Contractor Flint Engineering & Construction Company
Address Box 950, El Dorado, Kansas

STATE OF KANSAS COUNTY OF BUTLER, ss.

_____, (employee of owner) or (owner or operator) of the above-described well, being first duly sworn on oath, says: That I have knowledge of the facts, statements, and matters herein contained and the log of the above-described well as filed and that the same are true and correct. So help me God.

(Signature) Aurora Sawelle
El Dorado, Kansas
(Address)

SUBSCRIBED AND SWORN to before me this 25th day of May, 19 65

My commission expires 9-27-67

Ronald R. Hanson
Notary Public.


WELL LOG BUREAU KANSAS GEOLOGICAL SOCIETY
412 Union National Bk Bldg. Wichita, Kansas

Company - PETROLEUM INC. ET AL
Farm Mellies No. 1

SEC. 1 T. 22 R. 127
C7E NE NE

Total Depth. 3551'
Comm. 8-9-48 Comp. 8-21-48
Shot or Treated.
Contractor. J. D. Farrell Drlg. Co., Inc.
Issued. 11-13-48

County. Stafford
KANSAS

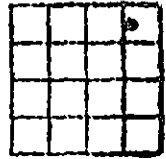

CASING:
5/8" 250' Com. 1/175 Sx. Circ.
5-1/2" 3550' Com. 1/150 Sx.

Elevation. _____

Production. 462 Bbls.

Figures Indicate Bottom of Formations.

cellar	5
post rock	40
sand & shale	140
shale & red bed.	570
anhydrite	585
shale & shells	1040
salt & shells	1335
shale & shells	1450
shale & lime	1825
lime	1900
lime & shale	2535
shale & shells	2690
lime brkn	2770
lime	2890
shale & lime	3005
lime	3050
lime & shale	3297
lime	3455
lime & chert	3492
lime & shale	3549
arbuckle	3551
Total Depth	

Tops:	
Anhydrite	570
Kansas ity	3212
Simpson	3496
Arbuckle	3549

3282-85 good jugular por.,
good sat. show free oil
in wet samples & semi-
oolitic lime.

3343-52 good por., good
sat., good show in
oolicastid lime.

3549 very slight stain in
xlym dolo, from 3549-51

Top Perf.

Bid Sheet Show Cement 100 lbs.

John Shaw

Top of Perf - 3277

RECEIVED
STATE CORPORATION COMMISSION
JUN 1 1965
CONSERVATION DIVISION
Wichita, Kansas