

STATE OF KANSAS  
STATE CORPORATION COMMISSION

WELL PLUGGING RECORD

Give All Information Completely  
Make Required Affidavit  
Mail or Deliver Report to:  
Conservation Division  
State Corporation Commission  
800 Bitting Building  
Wichita, Kansas

STAFFORD County. Sec. 1 Twp. 22 Rge. 12 (E) W (W)

Location as "NE/CNW&SW" or footage from lines GS/2-SW/4-NE/4-NE/4

Lease Owner PETROLEUM, Incorporated

Lease Name MELLIES "A" Well No. 4

Office Address 311 East Third, Wichita, Kansas

Character of Well (completed as Oil, Gas or Dry Hole) Oil

Date well completed May 21 19 53

Application for plugging filed Oct. 2 19 54

Application for plugging approved Oct. 26 19 54

Plugging commenced Oct. 27 19 54


Plugging completed Nov. 3 19 54

Reason for abandonment of well or producing formation

Depletion of producible zones.

If a producing well is abandoned, date of last production Sept. 27 19 54

Was permission obtained from the Conservation Division or its agents before plugging was commenced? Yes

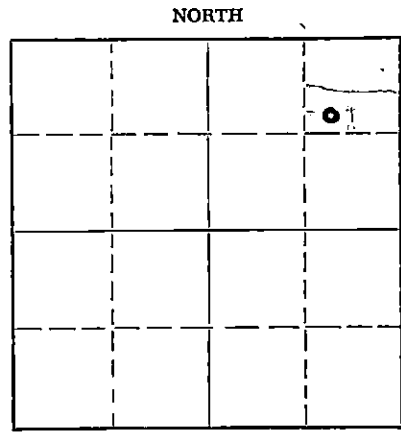

Locate well correctly on above Section Plat

Name of Conservation Agent who supervised plugging of this well M.A. Rives, Pratt, Kansas

Producing formation Kansas City Depth to top 3,217 Bottom --- Total Depth of Well 3,605 Feet

Show depth and thickness of all water, oil and gas formations.

OIL, GAS OR WATER RECORDS

CASING RECORD

FORMATION	CONTENT	FROM	TO	SIZE	PUT IN	PULLED OUT
Kansas City	Oil & Water	3,289'	3,295'	8-5/8"	248'	None
				4 1/2"	3,375'	2,040'

Describe in detail the manner in which the well was plugged, indicating where the mud fluid was placed and the method or methods used in introducing it into the hole. If cement or other plugs were used, state the character of same and depth placed, from \_\_\_\_\_ feet to \_\_\_\_\_ feet for each plug set.

(Drilled cement out to 3,334')

Filled hole with crushed rock from 3,334' to 3,275'.  
Placed 5 sacks cement from 3,275' to 3,225'. Mudded up with heavy mud from 3,225' to 240'; pushed wooden plug to 240', and built rock bridge from 240' to 235'. Filled hole with 20 sacks cement up to 60'. Mudded up to 35', set second wooden plug and filled hole to base of well cellar with 10 sacks cement.

11-10-54

(If additional description is necessary, use BACK of this sheet)

Name of Plugging Contractor Morgan Well Plugging Service  
Address 102 West 18th Street, Hutchinson, Kansas

STATE OF Kansas COUNTY OF Barton ss.  
Paul B. Shivel

(employee of owner) or (owner or operator) of the above-described well, being first duly sworn on oath, says: That I have knowledge of the facts, statements, and matters herein contained and the log of the above-described well as filed and that the same are true and correct. So help me God.


(Signature) Paul B. Shivel

Rural Route 2, Great Bend, Kansas (Address)

SUBSCRIBED AND SWORN TO before me this 5 th. day of November, 19 54

Ray L. Anderson Notary Public.

My commission expires November 21, 1957

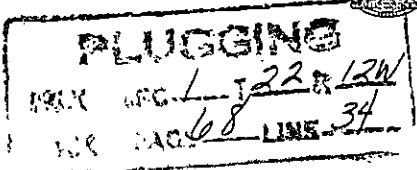

WELL LOG

Petroleum, Inc.  
Mellies "A" #4

CSL SW NE  
Section 1-22-12  
Stafford County, Kansas

Total Depth: 3605'  
Commenced: 4/29/53  
Completed: 5/12/53  
Contractor: J. D. Ferrell Drilling Co., Inc.  
Rotary: 0 - 3605'

Casing Record: 248.56' of 8 5/8" 24# casing; cemented at 246' with 175 sacks Pozmix cement and 3 sacks calcium chloride by HOWCO; cement circulated.  
3378.02 4 1/2" O.D. 11# cemented at 3375' with 75 sacks cement, 2% Gel.

Figures Indicate Bottoms of Formations:

Cellar	0 - 5	
Sand and Clay	5 - 40	
Sand	40 - 75	
Blue Shale	75 - 135	
Red Bed	135 - 247	Elevation: 1805' K. B.
Sand and Red Bed	247 - 880	
Shale and Shells	880 - 905	Tops:
Lime Anhydrite	905 - 920	Heebner 3061
Shale, Lime and Shells	920 - 1390	Brown Lime 3190
Shale and Shells	1390 - 1505	Kansas City 3217
Lime and Shale	1505 - 1790	Viola 3510
Sandy Lime	1790 - 1815	Simpson 3534
Lime and Shale	1815 - 1820	
Lime	1820 - 1890	
Lime and Shale	1890 - 2220	
Shale and Lime	2220 - 2365	
Lime and Shale	2365 - 2750	
Shale and Lime	2750 - 2890	
Lime and Shale	2890 - 3020	
Lime	3020 - 3105	
Shale and Lime	3105 - 3140	
Lime and Shale	3140 - 3217	
Lime	3217 - 3542	
Sand	3542 - 3553	
Shale	3553 - 3558	
Lime and Shale	3558 - 3605 T. D.	

We hereby certify this to be a correct and accurate log of the above-described well as shown on the Daily Drilling Reports.

J. D. FERRELL DRILLING CO., INC.

*J. D. Ferrell*

Subscribed and sworn to before me this 14th day of May, 1953.

*Emma Jean Sarge*  
Notary Public

My commission expires August 29, 1955.

