

STATE OF KANSAS
STATE CORPORATION COMMISSION

Form CP-4

15-055-20004-0000
WELL PLUGGING RECORD

Give All Information Completely
Make Required Affidavit
Mail or Deliver Report to:
Conservation Division
State Corporation Commission
212 No. Market
Wichita, Kansas

Finney County, Sec. 35 Twp. 23 Rge. (E) 33 (W)

Location as "NE/CNW/SW" or footage from lines 1390' North of Center of Section.

Lease Owner Pan American Petroleum Corporation

Lease Name Niederkleine Gas Unit Well No. 2

Office Address P. O. Box 432, Liberal, Kansas

Character of Well (completed as Oil, Gas or Dry Hole) Gas

Date well completed 12-5 19 67

Application for plugging filed 5-1 19 68

Application for plugging approved 5-2 19 68

Plugging commenced 5-8 19 68


Plugging completed 5-8 19 68

Reason for abandonment of well or producing formation During tests well logged off. Would not produce.

If a producing well is abandoned, date of last production Well not produced 19

Was permission obtained from the Conservation Division or its agents before plugging was commenced? Yes

NORTH

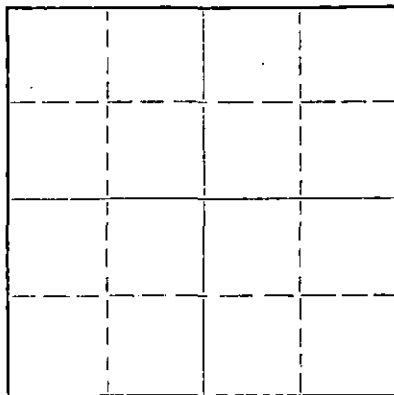

Locate well correctly on above Section Plat

Name of Conservation Agent who supervised plugging of this well Mr. E. Eves

Producing formation Harrington Depth to top 2580 Bottom 2618 Total Depth of Well 2623 Feet

Show depth and thickness of all water, oil and gas formations.

OIL, GAS OR WATER RECORDS

CASING RECORD

FORMATION	CONTENT	FROM	TO	SIZE	PUT IN	PULLED OUT
Harrington	Gas	2580	2618	8-5/8	516	0
				5 1/2	2635	0

Describe in detail the manner in which the well was plugged, indicating where the mud fluid was placed and the method or methods used in introducing it into the hole. If cement or other plugs were used, state the character of same and depth placed, from feet to feet for each plug set.

Well plugged from TD to surface with 350 sacks Pozmix cement pressure up to 1500# PSI.

5-20-68

RECEIVED
STATE CORPORATION COMMISSION
MAY 20 1968
CONSERVATION DIVISION
Wichita, Kansas

(If additional description is necessary, use BACK of this sheet)

Name of Plugging Contractor Halliburton Company

Address

STATE OF Kansas, COUNTY OF Seward, ss.

I, E. C. Woodall (employee of owner) or (~~owner or operator~~) of the above-described

well, being first duly sworn on oath, says: That I have knowledge of the facts, statements, and matters herein contained and the log of the above-described well as filed and that the same are true and correct. So help me God.


(Signature) E. C. Woodall E. C. WOODALL

P. O. Box 432, Liberal, Kansas
(Address)

Subscribed and sworn to before me this 15th day of May, 19 68

February 11, 1972

R. W. Banks
R. W. BANKS
Notary Public.

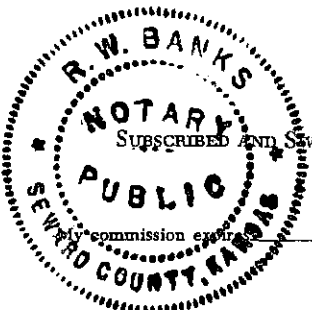

PAN AMERICAN PETROLEUM CORPORATION

WELL RECORD

SUPPLEMENTAL
(ENTER "X" WHEN APPLICABLE)

		0				
		35				

LOCATE WELL CORRECTLY

LEASE Niederkleine Gas Unit WELL NO. 2

LOCATION OF WELL: 1250 FT. NORTH SOUTH OF THE NORTH SOUTH LINE AND 2640 FT.

EAST WEST OF THE EAST WEST LINE OF THE _____ 1/4 _____ 1/4 _____ 1/4.

OF SECTION 35 TOWNSHIP 23 NORTH SOUTH. RANGE 33 EAST WEST.

Finney COUNTY Kansas STATE

ELEVATION: Ground 2890 RDB 2899

COMPLETED AS: OIL WELL GAS WELL WATER WELL DRY HOLE

DRILLING COMMENCED 10-24 19 67 COMPLETED 12-5 19 67

OPERATING COMPANY Pan American Petroleum Corporation ADDRESS Box 432, Liberal, Kansas

OIL OR GAS SANDS OR ZONES

NAME	FROM	TO	NAME	FROM	TO
1 <u>Herrington</u>	<u>2580</u>	<u>2618</u>	4		
2			5		
3			6		

RECEIVED
STATE CORPORATION COMMISSION
MAY 2 1968
CONSERVATION DIVISION
Wichita, Kansas

WATER SANDS

NAME	FROM	TO	WATER LEVEL	NAME	FROM	TO	WATER LEVEL
1 <u>Not Known</u>				3			
2				4			

CASING RECORD (OVERALL MEASUREMENT)

CSG. SIZE	DESCRIPTION			QUANTITY FEET
	WEIGHT	THREADS	MAKE - GRADE	
<u>5-1/2</u>	<u>14</u> <u>17</u>	<u>8</u>	<u>H-40</u>	<u>2635</u>
<u>8-5/8"</u>	<u>24</u>	<u>8</u>	<u>J-55</u>	<u>516</u>

LINER SCREEN RECORD

SIZE	QUANTITY FEET	SET AT		MAKE AND TYPE
		TOP	BOTTOM	

PACKER RECORD

SIZE	LENGTH	SET AT	MAKE AND TYPE

CEMENTING RECORD

SIZE	WHERE SET FEET	CEMENT			METHOD	FINAL PRESS
		SACKS	BRAND	TYPE		
<u>5-1/2</u>	<u>2622</u>	<u>750</u>	<u>Pozmix</u>	<u>Bulk</u>	<u>Halliburton</u>	
<u>8-5/8"</u>	<u>520</u>	<u>500</u>	<u>Pozmix</u>	<u>Bulk</u>	<u>Dowell</u>	

MUDDING RECORD

(CABLE TOOLS)	
METHOD	RESULTS

WHAT METHOD WAS USED TO PROTECT SANDS WHEN OUTER STRINGS WERE PULLED? _____

WERE BOTTOM HOLE PLUGS USED? _____

IF SO, STATE KIND, DEPTH SET, AND RESULTS OBTAINED _____

ROTARY TOOLS WERE USED FROM 0 FEET TO 2623 FEET, AND FROM _____ FEET TO _____ FEET

CABLE TOOLS WERE USED Asm To Test FEET TO _____ FEET, AND FROM _____ FEET TO _____ FEET

24-HOUR PRODUCTION OR POTENTIAL TEST _____

WATER _____ BBLs.

IF GAS WELL, CUBIC FEET PER 24 HOURS 1,280,000 SHUT-IN PRESSURE 326 LBS. PER SQUARE IN.

I, THE UNDERSIGNED, BEING FIRST DULY SWORN UPON OATH, STATE THAT THIS WELL RECORD IS TRUE AND CORRECT ACCORDING TO THE RECORDS OF THIS OFFICE AND TO THE BEST OF MY KNOWLEDGE AND BELIEF.

SUBSCRIBED AND SWORN TO BEFORE ME THIS 18 DAY OF December, 19 67 AND TITLE _____

Area Foreman

MY COMMISSION EXPIRES February 11, 1968

NOTARY PUBLIC

FORMATION RECORD

DESCRIBE EACH FORMATION DRILLED. INDICATE THICKNESS, CONTENT AND WHETHER DRY, OR OIL, GAS, OR WATER BEARING.

FORMATION	TOP	BOTTOM	FORMATION	TOP	BOTTOM
Clay, Sand	0	525			
Shale	525	620			
Red Bed, Shells	620	1240			
Sand	1240	1338			
Shells, Sand	1338	1536			
Shale, Red Bed	1536	2150			
Shale	2150	2590			
Lime, Shale	2590	2609			
Lime	2609	2623			
Total Depth		2623			
Plug Back Depth		2618			