


Give All Information Completely  
Make Required Affidavit  
Mail or Deliver Report to:  
Conservation Division  
State Corporation Commission  
800 Bittig Building  
Wichita, Kansas

WELL PLUGGING RECORD

15-055-00814-0000

NORTH

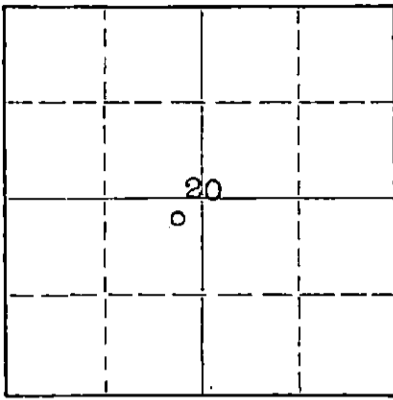

Locate well correctly on above Section Plat

Finney County. Sec. 20 Twp. 23 Rge. 33 (E) W (W)  
Location as "NE/CNW/SW" or footage from lines NE NE SW  
Lease Owner Northern Pump Company  
Lease Name Garden City Company Well No. 2  
Office Address Box 94, Great Bend, Kansas  
Character of Well (completed as Oil, Gas or Dry Hole) Gas  
Date well completed April 23 19 52  
Application for plugging filed January 17 19 58  
Application for plugging approved January 20 19 58  
Plugging commenced January 20 19 58  
Plugging completed January 24 19 58  
Reason for abandonment of well or producing formation Dry

If a producing well is abandoned, date of last production April 19 57  
Was permission obtained from the Conservation Division or its agents before plugging was commenced? Yes

Name of Conservation Agent who supervised plugging of this well M. A. Rives  
Producing formation Herington, Krider & Winfield Depth to top 2532 Bottom 2629 Total Depth of Well 2680 Feet  
Show depth and thickness of all water, oil and gas formations.

OIL, GAS OR WATER RECORDS

CASING RECORD

FORMATION	CONTENT	FROM	TO	SIZE	PUT IN	PULLED OUT
Herington		2532'		8-5/8"	388'	None
Krider		2548'		5-1/2"	2634'	None
Winfield		2579'				
Towanda		2637'				

Describe in detail the manner in which the well was plugged, indicating where the mud fluid was placed and the method or methods used in introducing it into the hole. If cement or other plugs were used, state the character of same and depth placed, from \_\_\_\_\_ feet to \_\_\_\_\_ feet for each plug set.

Plugging Record:

Sand and Gravel Plug from 2600' to 2680' T.D.  
Spot 4 Sacks Common Cement  
Mud up to 400'  
Set Gravel Bridge Plug  
Spot 15 Sacks Common Cement  
Mud up to 40' of Surface  
Set Gravel Bridge Plug  
Cement from 40' to base of Cellar 4' Under Surface  
All Casing was Cemented & Circulated to Top.

RUP JAN 28 1958  
01-28-58  
CONSERVATION DIVISION  
Wichita, Kansas

(If additional description is necessary, use BACK of this sheet)  
Name of Plugging Contractor Northern Pump Company  
Address Box 94, Great Bend, Kansas

STATE OF KANSAS, COUNTY OF BARTON, ss.  
Carolyn Dennis (employee of owner) or (owner or operator) of the above-described well, being first duly sworn on oath, says: That I have knowledge of the facts, statements, and matters herein contained and the log of the above-described well as filed and that the same are true and correct. So help me God.

(Signature) Carolyn Dennis  
Carolyn Dennis  
Box 94, Great Bend, Kansas  
(Address)

SUBSCRIBED AND SWORN to before me this 27th day of January, 19 58

My commission expires January 28, 1959  
Claudine Turner  
Claudine Turner Notary Public.

PLUGGING  
FILE SEC 20 23R.33  
BOOK PAGE 76 LINE 71

15-055-00814-0000

RECEIVED  
STATE CORPORATION COMMISSION

JAN 18 1958

CONSERVATION DIVISION  
Wichita, Kansas

Contractor:  
Ben F. Brack Oil Company, Inc.  
310 Brown Building  
Wichita, Kansas

Northern Pump Company  
Garden City Company #2  
NE NE SW  
Sec. 20-T23S-R33W  
Finney County, Kansas

Elevation: Ground 2899'  
D.F. 2902'

TOTAL DEPTH: 2680'  
Commenced: January 8, 1952  
Completed: April 23, 1952  
Casing: 388' - 8-5/8" Casing - Cement w/225 sacks  
2634' - 5-1/2" Casing - Cement w/800 sacks

Following depths denote bottom of formation:

Clay and Sand	0 - 45	
Sand	350	
Blue Shale	388	
Shale	425	
Shale and Shells	990	
Redbed	1015	
Redbed and Shale	1325	
Shale and Shells	1410	
Anhydrite	1435	
Shale and Shells	1445	
Shale and Redbed	1510	
Sand	1775	
Shale	1825	
Salt and Shale	1850	
Shale	1990	
Shale and Lime	2020	
Lime and Shale	2250	
Shale and Lime Streaks	2375	
Lime and Shale	2420	
Broken Lime and Red Shale	2510	
Lime and Shale	2680	Rotary Total Depth

FORMATIONS

Herrington	2532
Krider	2548
Winfield	2579
Towanda	2637

PLUGGING
WT SEC 20 T 23 R 33 W
BOOK PAGE 16 LINE 41