

15-055-00806-0000
WELL PLUGGING RECORD

Give All Information Completely
Make Required Affidavit
Mail or Deliver Report to:
Conservation Division
State Corporation Commission
211 No. Broadway
Wichita, Kansas

Finney

County. Sec. 12 Twp. 23S Rge. (X) 33 (W)

Location as "NE/CNW/SW" or footage from lines C-SW-SW

Lease Owner Petroleum Inc.

Lease Name Friesen "B" Well No. 1

Office Address P. O. Box 1255

Character of Well (completed as Oil, Gas or Dry Hole) Dry Hole

Date well completed November 11 19 65

Application for plugging filed November 11 19 65

Application for plugging approved November 11 19 65


Plugging commenced November 11 19 65

Plugging completed November 11 19 65

Reason for abandonment of well or producing formation _____

If a producing well is abandoned, date of last production _____ 19 _____

Was permission obtained from the Conservation Division or its agents before plugging was commenced? Yes

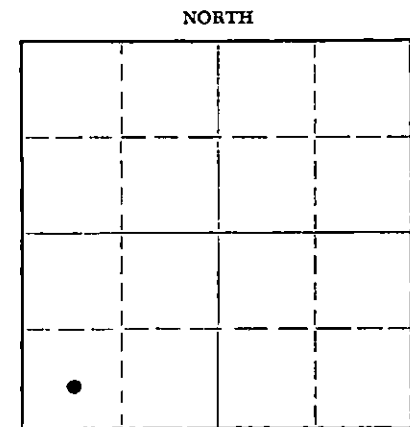

Locate well correctly on above Section Plat

Name of Conservation Agent who supervised plugging of this well Hugh Scott

Producing formation None Depth to top _____ Bottom _____ Total Depth of Well 4948 Feet

Show depth and thickness of all water, oil and gas formations.

OIL, GAS OR WATER RECORDS

CASING RECORD

| FORMATION | CONTENT | FROM | TO | SIZE | PUT IN | PULLED OUT |
|-----------|---------|------|----|--------|--------|------------|
| | | | | 8-5/8" | 565' | None |
| | | | | | | |
| | | | | | | |
| | | | | | | |
| | | | | | | |
| | | | | | | |
| | | | | | | |

Describe in detail the manner in which the well was plugged, indicating where the mud fluid was placed and the method or methods used in introducing it into the hole. If cement or other plugs were used, state the character of same and depth placed, from _____ feet to _____ feet for each plug set.

Mudded up with heavy mud from 4948' to 550' followed by 35 sacks cement to 445'.
Mudded up with heavy mud to 30' followed by 15 sacks cement to base of well cellar.

Handwritten: Rwd
11-19-65

(If additional description is necessary, use BACK of this sheet)

Name of Plugging Contractor Garvey Drilling Company

Address R. R. #2 Great Bend, Kansas

STATE OF Kansas, COUNTY OF Seward, ss.

Harold L. Young (employee of owner) or (~~owner or operator~~) of the above-described well, being first duly sworn on oath, says: That I have knowledge of the facts, statements, and matters herein contained and the log of the above-described well as filed and that the same are true and correct. So help me God.

(Signature) Harold L. Young

P. O. Box 1255 Liberal, Kansas

SUBSCRIBED AND SWORN TO before me this 19th day of November, 19 65

Richard D. Junk
Notary Public.

My commission expires January 20, 1969

WELL LOG

15-055-00806-1000

COMPANY Petroleum, Inc.

SEC. 12 T23S R. 33W

FARM Friesen

NO. B-1

LOC. C-SW-SW

TOTAL DEPTH 4950'

COUNTY Finney

COMM. 10-28-65

COMP. 11-11-65

CONTRACTOR Garvey Drilling Company

| | | | |
|--|--|--|--|
| | | | |
| | | | |
| | | | |
| | | | |

CASING 8 5/8" @ 565' w/400 sx

ELEVATION

PRODUCTION D & A

FIGURES INDICATE BOTTOM OF FORMATIONS

- 565' Sand, Clay and Shale
- 1303' Red Bed, Clay and Shale
- 1741' Shale and Anhydrite
- 1988' Shale, Shells, Anhydrite
- 2400' Shale and Lime
- 2585' Lime and Shale
- 2910' Shale and Lime
- 3010' Lime and Shale
- 3215' Lime
- 3380' Lime and Shale
- 3545' Lime, Shale, and Chalk Streaks
- 4430' Lime and Shale
- 4735' Lime
- 4780' Shale and Lime
- 4950' Lime
- 4950' RTD

State of Kansas }
 County of Barton } ss

I, Sam N. Stephens of Garvey Drilling Company

upon oath state the above and foregoing is a true and correct copy of the log of the Friesen B-1 well.

Sam N. Stephens

Subscribed and sworn to before me this 17th day of November 19 65

My Commission Expires: November 5, 1969

Richard S. Doy
 NOTARY PUBLIC