

STATE OF KANSAS  
STATE CORPORATION COMMISSION

WELL PLUGGING RECORD

Give All Information Completely  
Make Required Affidavit  
Mail or Deliver Report to:  
Conservation Division  
State Corporation Commission  
800 Bitting Building  
Wichita, Kansas

OR  
FORMATION PLUGGING RECORD

Strike out upper line  
when reporting plug-  
ging off formations.

NORTH

Locate well correctly on above  
Section Flat

Barton County. Sec. 25 Twp 19 Rge 14 (E) W (W)  
Location as "NE $\frac{1}{4}$ NW $\frac{1}{4}$ SW $\frac{1}{4}$ " or footage from lines. NW $\frac{1}{4}$  NW $\frac{1}{4}$  NE $\frac{1}{4}$   
Lease Owner. Adkins Drilling Company, Inc.  
Lease Name. Matilda Koch Well No. 1  
Office Address. Great Bend, Kansas.  
Character of Well (completed as Oil, Gas or Dry Hole) Dry Hole  
Date well completed. Jan. 7- 1952 19  
Application for plugging filed. Jan. 20- 1952 19  
Application for plugging approved. Jan. 20- 1952 19  
Plugging commenced. Jan. 20- 1952 19  
Plugging completed. Jan. 20- 1952 19  
Reason for abandonment of well or producing formation. Dry Hole  
If a producing well is abandoned, date of last production. 19  
Was permission obtained from the Conservation Division or its agents before plugging was commenced? Yes

Name of Conservation Agent who supervised plugging of this well. C. D. Stough  
Producing formation. Depth to top. Bottom. Total Depth of Well. 3581 Feet  
Show depth and thickness of all water, oil and gas formations.

OIL, GAS OR WATER RECORDS

CASING RECORD

Formation	Content	From	To	Size	Put In	Pulled Out
Sand & Shale		0	740			
Red Bed & Anhydrite		740	781	8 5/8"	780'	None

Describe in detail the manner in which the well was plugged, indicating where the mud fluid was placed and the method or methods used in introducing it into the hold. If cement or other plugs were used, state the character of same and depth placed, from \_\_\_\_\_ feet to \_\_\_\_\_ feet for each plug set.

Hole was filled with heavy mud and permanent plug set @ 270' and cemented with 15 Sacks of cement, then heavy mud to bottom of cellar and permanent plug placed there and cemented with 10 sacks of cement from 30 ft. to ground level.

(If additional description is necessary, use BACK of this sheet)

Correspondence regarding this well should be addressed to Adkins Drilling Company, Inc.  
Address. P. O. Box 724 Great Bend, Kansas.

STATE OF Kansas, COUNTY OF Barton, ss.  
Jim Adkins (employee of owner) or (owner or operator) of the above-described well,  
being first duly sworn on oath, says: That I have knowledge of the facts, statements, and matters herein contained and the log of the above-described well as filed and that the same are true and correct. So help me God.

(Signature)

1502- 12th St Great Bend, Kansas.  
(Address)

SUBSCRIBED AND SWORN to before me this 22nd day of January, 1952.

Notary Public.

My commission expires

1-26-1952.

PLUGGING 20-1500-3 11-43-10M  
FILE SEC 25-19-14  
PAGE 139 LINE 4

FEB 1 X 1952

2-1-52

DRILLERS LOG

Lease Operator: Adkins Drilling Company, Inc.

Contractor: Adkins Drilling Company, Inc.

Lease: Matilda Koch No. 1,

Location: NW NW of NE $\frac{1}{4}$  Section 25 Twp 19S. Range 14 West, Barton County, Kansas.

Completed January 21- 1952.

Formation	From	To	Formation	From	To
Sand & Shale	0	240			
Shale	240	275			
Sand	275	300			
Sand & Shale	300	740			
Red Bed	740	767			
Anhydrite	767	781			

Set 8 5/8" @ 780' cemented w/ 200  
sacks of cement and 2% Calcium Chloride

Plug	747	748
Cement	748	780
Open Hole	780	781
Anhydrite	781	786
Red Bed & Shale	786	1675
Shale & Lime	1675	2410
Shale	2410	2820
Shale & Lime	2820	2940
Lime & Shale	2940	3195
Lime	3195	3465
Conglomerite	3465	3502
Dolomite	3502	3581

T. D. 3581' Dry, plugged and abandoned.


I, Jim Adkins, hereby swear that the foregoing is a true and correct copy, of the Drillers Log on Koch No. 1 drilled in NW $\frac{1}{4}$  of NE $\frac{1}{4}$  of Section 25 Twp. 19 Range 14 West in Barton County, Kansas.

Subscribed and sworn to before me this 22nd day of January 1952.

*Pauline B. Adkins*  
Notary Public.

My Commission expires

1-26-1952.

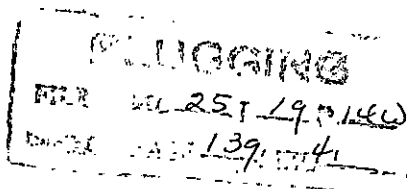

FEB 1 X 1952