


WELL PLUGGING RECORD

Give All Information Completely
Make Required Affidavit
Mail or Deliver Report to:
Conservation Division
State Corporation Commission
800 Bitting Building
Wichita, Kansas

Barton County. Sec. 25 Twp. 19 Rge. (#) 14(W)
Location as "NE/CNW%SW%" or footage from lines C S/2 S/2 NE
Lease Owner Thos. H. Allan, et al
Lease Name Koch Well No. 1
Office Address 1221 Union National Bank Bldg., Wichita 2, Kansas
Character of Well (completed as Oil, Gas or Dry Hole) Oil
Date well completed 8/11 19 52
Application for plugging filed 7/22 19 53
Application for plugging approved 7/22 19 53
Plugging commenced 8/3 19 53
Plugging completed 8/8 19 53
Reason for abandonment of well or producing formation Exhausted

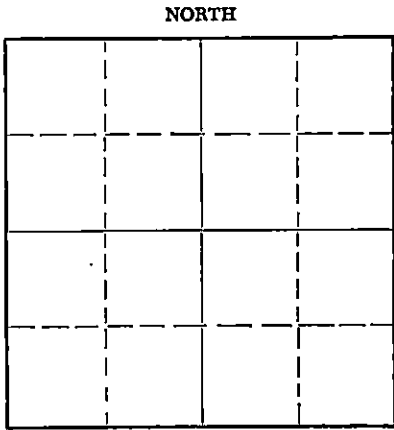

Locate well correctly on above Section Plat

If a producing well is abandoned, date of last production 7/20 19 53
Was permission obtained from the Conservation Division or its agents before plugging was commenced? Yes

Name of Conservation Agent who supervised plugging of this well C. D. Stough
Producing formation Kansas City Depth to top 3363 Bottom 3368 Total Depth of Well 3368 Feet
Show depth and thickness of all water, oil and gas formations.

OIL, GAS OR WATER RECORDS

CASING RECORD

FORMATION	CONTENT	FROM	TO	SIZE	PUT IN	PULLED OUT
				8 5/8"	783'	None
				5 1/2"	3324'	2549'

Describe in detail the manner in which the well was plugged, indicating where the mud fluid was placed and the method or methods used in introducing it into the hole. If cement or other plugs were used, state the character of same and depth placed, from _____ feet to _____ feet for each plug set.

3368 - 3300 Sand
3300 - 3250 5 sacks cement
3250 - 275 Heavy Mud
275 - 260 Rock Bridge
260 - 200 20 sacks cement
200 - 30 Heavy Mud
30 - Surface 10 sacks cement

8-19-53

FILED
STATE CORPORATION COMMISSION
AUG 15 1953
CONSERVATION DIVISION
WICHITA, KANSAS

(If additional description is necessary, use BACK of this sheet)
Name of Plugging Contractor B and W Casing Pulling Co.
Address Great Bend, Kansas

STATE OF KANSAS, COUNTY OF SEDGWICK, ss.
Thos. H. Allan (employee of owner) or (owner or operator) of the above-described well, being first duly sworn on oath, says: That I have knowledge of the facts, statements, and matters herein contained and the log of the above-described well as filed and that the same are true and correct. So help me God.

(Signature) Thos. H. Allan
1221 Union National Bank Bldg., Wichita 2, Kans.
(Address)

SUBSCRIBED AND SWORN to before me this 18th day of August, 19 53
Oris M. Stewart
Notary Public.

My commission expires June 14, 1954

PLUGGING
FILED SEC 25 T 19 R 14 W
BOOK PAGE 117 LINE 1

8 5/8" @ 783 - 275 ex
5 1/2" @ 3324 - 100 ex

Allan, et al #1 KOSH
C S/2 S/2 NE 25-19-14W
Barton County, Kansas
COMM: 7/22/52 COMPL: 8/11/52
CONTRACTOR: Tom Allan
ELEVATION: 1870 DF
1872 RB

I.P. 30 BOPD

Depth from Rotary Bushings

- 0 - 15 Surface Soil
- 115 Sand & Gravel
- 290 Shale
- 315 Sand
- 773 Red Beds
- 798 Anhydrite
- 1180 Red & Gray Shale
- 1280 Gray Shale
- 1500 Shale & Salt
- 1600 Shale, Salt & Anhydrite
- 1740 Shale & Anhydrite
- 1760 Shale
- 2380 Lime & Shale
- 2780 Shale & Shells
- 3125 Lime & Shale
- 3188 Shale & Sand
- 3324 (RTD) Lime with Shale Breaks
- 3324 RB = 3322 DF
- 3341 DF Lime
- 3344 DF Shale
- 3354 DF Lime
- 3359 DF Shale
- 3368 DF (TD) Lime

FORMATIONS:

Anhydrite	773 RB
Heebner	3093 RB
Brown Lime	3188 RB
Lansing	3200 RB

TESTING:

Show Oil 3363 DF
 Bail 10 GPH.
 300 gal. Acid
 Swab 1 1/2 BOPD
 1000 gal. Acid
 Swab 30 BOPD

PLUGGING
 DATE REC-25-19-14W
 WEL: FAC-16-11-52

RECEIVED
 STATE CORPORATION COMMISSION
 JUL 22 1953
 CONSERVATION DIVISION
 Wichita, Kansas