


STATE OF KANSAS
STATE CORPORATION COMMISSION

Give All Information Completely
Make Required Affidavit
Mail or Deliver Report to:
Conservation Division
State Corporation Commission
211 No. Broadway
Wichita, Kansas

WELL PLUGGING RECORD

NORTH

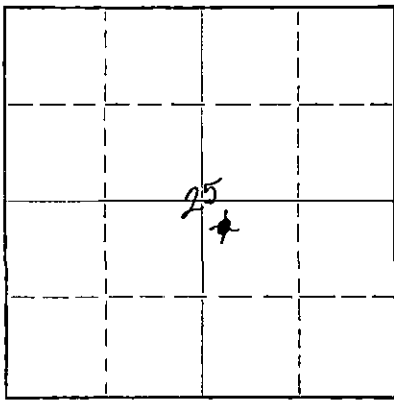

Locate well correctly on above
Section Plat

Barton County. Sec. 25 Twp. 19 Rge. (E) 14 (W)
Location as "NE/CNW%SW%" or footage from lines NW NW SE
Lease Owner Thos. H. Allan, et al
Lease Name Clarke Well No. 1
Office Address 925 Union Center, Wichita 2, Kansas
Character of Well (completed as Oil, Gas or Dry Hole) Oil
Date well completed January 23 19 52
Application for plugging filed April 22 19 58
Application for plugging approved April 22 19 58
Plugging commenced April 22 19 58
Plugging completed April 25 19 58
Reason for abandonment of well or producing formation Exhausted

If a producing well is abandoned, date of last production January 19 58
Was permission obtained from the Conservation Division or its agents before plugging was commenced? Yes

Name of Conservation Agent who supervised plugging of this well Donald Truan
Producing formation Kansas City Depth to top 3322' Bottom 3327' Total Depth of Well 3349 Feet
Show depth and thickness of all water, oil and gas formations.

OIL, GAS OR WATER RECORDS

CASING RECORD

FORMATION	CONTENT	FROM	TO	SIZE	PUT IN	PULLED OUT
				8 5/8"	780	None
				5 1/2"	3508	2700'

Describe in detail the manner in which the well was plugged, indicating where the mud fluid was placed and the method or methods used in introducing it into the hole. If cement or other plugs were used, state the character of same and depth placed, from _____ feet to _____ feet for each plug set.

Plugged back 3349 feet to 3310 feet with sand and cement.
Pulled pipe to 1000 feet. Circulated 25 sacks of mud.
Pulled pipe to 300 feet. Pumped in 25 sacks of cement.
Finished pulling pipe. Set bridge at 40 feet - finished filling hole with cement.

(If additional description is necessary, use BACK of this sheet)

Name of Plugging Contractor E & L Casing Pulling Co.
Address 1416 Coolidge, Great Bend, Kansas

STATE OF KANSAS, COUNTY OF SEDGWICK, ss.
Thos. H. Allan (employee of owner) or (owner or operator) of the above-described

well, being first duly sworn on oath, says: That I have knowledge of the facts, statements, and matters herein contained and the log of the above-described well as filed and that the same are true and correct. So help me God.

(Signature)

Thos. H. Allan
925 Union Center, Wichita 2, Kansas
(Address)

SUBSCRIBED AND SWORN to before me this 1st day of May, 19 58

My commission expires June 14, 1958

Notary Public.

PLUGGING
FILE SEC 25 T 19 R 14W
BOOK PAGE 94 LINE 37

RECEIVED
STATE CORPORATION COMMISSION

MAY 3 1958

CONSERVATION DIVISION
Wichita, Kansas

5-3-58

8 5/8" @ 700' 275 sx

5 1/2" @ 3508' 125 sx

ALLAN, et al #1 CLARKE
 NW NW SE 25-19-14W
 Barton County, Kansas
 Comm: 1/1/52 Compl: 1/23/52
 CONTRACTOR: Tom Allan
 ELEVATION: 1870 DF
 1872 RB
 I. P. Swab 12 BOPH

Depth from Rotary Bushings

0 -	15	Surface Soil & Sand
	130	Sand
	200	Sand & Shale
	285	Shale
	320	Sand
	774	Red Beds
	780	Anhydrite
	1180	Red & Gray Shale with Anhydrite Stringers
	1280	Gray Shale
	1500	Shale & Salt
	1600	Shale, Salt & Anhydrite
	1740	Shale & Anhydrite
	1760	Shale
	2380	Lime & Shale
	2780	Shale & Shells
	3120	Lime & Shale
	3187	Shale & Sand
	3420	Lime with Shale Breaks
	3484	Shale & Chert
	3508 1/2	(RTD) White Chert
	3508 1/2	RB = 3506 1/2 DF
	3507	DF Brownish Orange Chert
	3515	DF (TD) White Crystalline Dolomite
		Bail 1/2 bbl. Black Sulfur water per hour

TESTING: (Measurements from Rotary Bushings)

Plug Back to 3442 & Perforate 24
 Shots from 3358-63
 Acidize with 500 gal. Acid - Swab
 10 BOPH
 Plug Back to 3349 & Perforate 23
 Shots from 3322-27
 Acidize with 1000 gal. Acid - Swab
 12 BOPH
 Acidize with 1500 Gal. Acid - Swab
 12 BOPH

FORMATIONS:

Heebner	3090 RB
Brown Lime	3187 RB
Lansing	3197 RB
Conglomerate	3421 RB
Cherty Conglomerate	3446 RB
Arbuckle	3509 RB

PLUGGING

FILE 10-26-71 19 14W
 DECK PAGE 94 LINE 37