


STATE OF KANSAS
STATE CORPORATION COMMISSION

WELL PLUGGING RECORD

Give All Information Completely
Make Required Affidavit
Mail or Deliver Report to
Conservation Division
State Corporation Comm.
245 North Water
Wichita, KS 67202

Pawnee County, Sec. 25 Twp. 21S Rge. 15 X&W
Location as "NE/CNW $\frac{1}{4}$ SW $\frac{1}{4}$ " or footage from lines
E/2 SW NE

Lease Owner F & M Oil Company, Inc.
Lease Name Woelk Well No. 1
Office Address 422 Union Center, Wichita, Kansas 67202
Character of Well (Completed as Oil, Gas or Dry Hole)

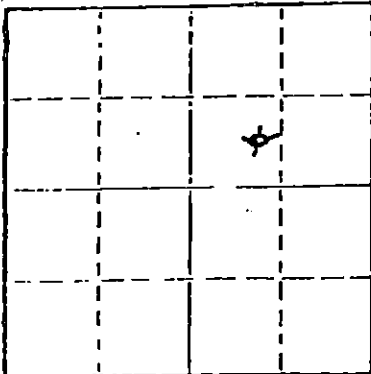

Locate well correctly on above
Section Plot

Dry Hole
Date Well completed 10-10-80 19
Application for plugging filed 10-10-80 19
Application for plugging approved 10-10-80 19
Plugging commenced 10-10-80 19
Plugging completed 10-10-80 19
Reason for abandonment of well or producing formation
N/A

If a producing well is abandoned, date of last production
Dry Hole 19

Was permission obtained from the Conservation Division or
its agents before plugging was commenced? Yes

Name of Conservation Agent who supervised plugging of this well Gil Balthazor
Producing formation _____ Depth to top _____ Bottom _____ Total Depth of Well 3792'
Show depth and thickness of all water, oil and gas formations.

OIL, GAS OR WATER RECORDS

CASING RECORD

FORMATION	CONTENT	FROM	TO	SIZE	PUT IN	PULLED OUT
Sand				8 5/8"	1017'	None

Describe in detail the manner in which the well was plugged, indicating where the mud fluid
was placed and the method or methods used in introducing it into the hold. If cement or other
plugs were used, state the character of same and depth placed, from _____ feet to
_____ feet for each plug set.

70 Sx 600'
10 Sx 40'
5 Sx RH
5 Sx WW

10-17-80

50-50 PAZ 6% gel

RECEIVED
STATE CORPORATION COMMISSION

(If additional description is necessary, use BACK of this sheet) 17 1980

Name of Plugging Contractor

CONSERVATION DIVISION
Wichita, Kansas

STATE OF Kansas COUNTY OF Sedgwick, ss.
Paul A. Seymour, Jr. (employee of owner) or (owner or operator)
of the above-described well, being first duly sworn on oath, says: That I have knowledge of
the facts, statements, and matters herein contained and the log of the above-described well
as filed and that the same are true and correct. So help me God.

(Signature) Paul A. Seymour, Jr.
Box 8287, Munger Station, Wichita, Ks. 67208
(Address)

SUBSCRIBED AND SWORN TO before me this 15th day of October, 1980

My commission expires

May 30 1983



Ruth M. Bassett
Notary Public.

BIG SPRINGS DRILLING, INC.

P.O. BOX 8287
MUNGER STATION
WICHITA, KANSAS 67208

SUITE 29 • 400 NORTH WOODLAWN • (316) 681-1732

October 15, 1980

DRILLERS LOG

Re: Woelk No. 1
E/2 SW NE
Sec. 25 Twp 21S Rg 15W
Pawnee County, Kansas

OPERATOR: F and M Oil Company, Inc.
CONTRACTOR: Big Springs Drilling, Inc.
COMMENCED: October 3, 1980
COMPLETED: October 10, 1980

Surface Pipe: 1017' of 8 5/8" w/225 Sx 50-50 PAZ 3% cc1 4% gel and
175 Sx Common 3% gel 3% cc1

0	878	Shale, Sand & Redbeds
878	902	Anhydrite
902	1017	Shale & Sand
1017	2885	Shale & Lime
2885	3792	Lime
3792		RTD

We certify that the above and foregoing is a true and correct copy of the log on the #1 Woelk located in Pawnee County, Kansas.


RECEIVED
STATE CORPORATIONS COMMISSION
OCT 17 1980
CONSERVATION DIVISION
Wichita, Kansas

Big Springs Drilling, Inc.


Paul A. Seymour, Jr.

Subscribed and sworn to before me this 15th day of October, 1980.


RUTH M. BASSETT
STATE NOTARY PUBLIC
Sedgewick County, Kansas
My Appt. Exp. _____

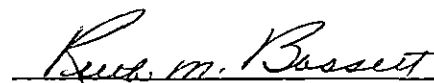
Ruth M. Bassett

My Commission Expires:

May 30, 1983