

STATE OF KANSAS
STATE CORPORATION COMMISSION

WELL PLUGGING RECORD

Give All Information Completely
Make Required Affidavit
Mail or Deliver Report to
Conservation Division
State Corporation Comm.
245 North Water
Wichita, KS 67202

Pawnee County, Sec. 27 Twp. 21S Rge. 15W E/W
Location as "NE/CNW $\frac{1}{4}$ SW $\frac{1}{4}$ " or footage from lines
100' East of NW NW SW

Lease Owner F & M OIL CO., INC.

Lease Name Jost Well No. 2

Office Address 422 Union Center, Wichita, Ks. 67202

Character of Well (Completed as Oil, Gas or Dry Hole)
Dry Hole

Date Well completed August 7, 1983

Application for plugging filed August 7, 1983

Application for plugging approved August 7, 1983

Plugging commenced August 7, 1983

Plugging completed August 7, 1983

Reason for abandonment of well or producing formation
Dry Hole


If a producing well is abandoned, date of last production
----- 19

Was permission obtained from the Conservation Division or
its agents before plugging was commenced? Yes

Name of Conservation Agent who supervised plugging of this well Steve Durrant

Producing formation ----- Depth to top -- Bottom --- Total Depth of Well 3944'

Show depth and thickness of all water, oil and gas formations.

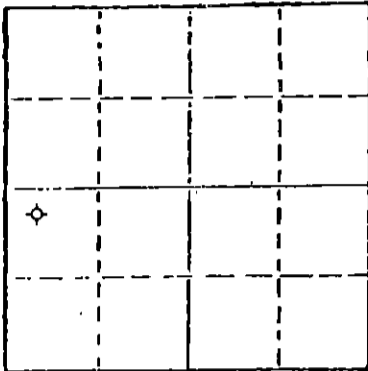

Locate well correctly on above
Section Plat

OIL, GAS OR WATER RECORDS

CASING RECORD

FORMATION	CONTENT	FROM	TO	SIZE	PUT IN	PULLED OUT

Describe in detail the manner in which the well was plugged, indicating where the mud fluid was placed and the method or methods used in introducing it into the hold. If cement or other plugs were used, state the character of same and depth placed, from _____ feet to _____ feet for each plug set.

Set 1st plug @ 950' w/50 sxs

Set 2nd plug @ 450' w/40 sxs

Set 3rd plug @ 40' w/10 sxs

15 sxs in the rat hole, 5 sxs in the water well

plug down @ 7 AM 8-7-83

(If additional description is necessary, use BACK of this sheet)

Name of Plugging Contractor Union Drilling Co., Inc.

STATE OF Kansas COUNTY OF Sedgwick, ss.
R. D. Messinger (employee of owner) or (owner or operator)

of the above-described well, being first duly sworn on oath, says: That I have knowledge of the facts, statements, and matters herein contained and the log of the above-described well as filed and that the same are true and correct. So help me God.

(Signature) R. D. Messinger

422 Union Center, Wichita, Ks. 67202
(Address)

SUBSCRIBED AND SWORN TO before me this 25th day of August, 1983

Shirley A. Gallegos
Notary Public.

My commission expires 12-24-84



RECEIVED
STATE CORPORATION COMMISSION

SEP 1 1983

CONSERVATION DIVISION
Wichita, Kansas

9-1-83