

STATE OF KANSAS  
STATE CORPORATION COMMISSION

WELL PLUGGING RECORD

Give All Information Completely  
Make Required Affidavit  
Mail or Deliver Report to:  
Conservation Division  
State Corporation Commission  
800 Bittling Building  
Wichita, Kansas

Pawnee County, Sec. 31 Twp. 21 Rge. 15 (E) 15 (W)

Location as "NE/CNW#SW#" or footage from lines NE NW SE

Lease Owner Great Bend Pipe & Supply

Lease Name Robert Well No. 1

Office Address Great Bend, Kansas

Character of Well (completed as Oil, Gas or Dry Hole) \_\_\_\_\_

Date well completed \_\_\_\_\_ 19 \_\_\_\_\_

Application for plugging filed Jan. 12 19 56

Application for plugging approved Jan. 14 19 56


Plugging commenced 1-15 19 56

Plugging completed 1--20 19 56

Reason for abandonment of well or producing formation \_\_\_\_\_

If a producing well is abandoned, date of last production \_\_\_\_\_ 19 \_\_\_\_\_

Was permission obtained from the Conservation Division or its agents before plugging was commenced? Yes

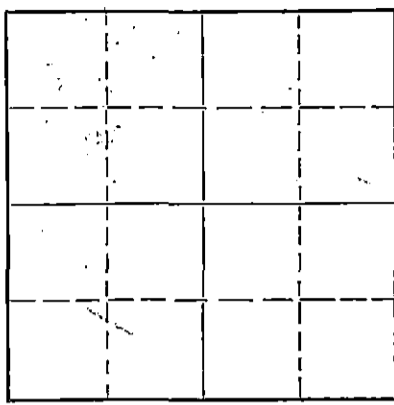

Locate well correctly on above  
Section Plat

Name of Conservation Agent who supervised plugging of this well \_\_\_\_\_

Producing formation Arkuda Depth to top 3908 Bottom 3900 Total Depth of Well 3916 Feet

Show depth and thickness of all water, oil and gas formations.

OIL, GAS OR WATER RECORDS

CASING RECORD

FORMATION	CONTENT	FROM	TO	SIZE	PUT IN	PULLED OUT
		0	570	8 5/8"		none
		0	3908	5 1/2"		821 3206'

Describe in detail the manner in which the well was plugged, indicating where the mud fluid was placed and the method or methods used in introducing it into the hole. If cement or other plugs were used, state the character of same and depth placed, from \_\_\_\_\_ feet to \_\_\_\_\_ feet for each plug set.

Sanded hole to 3900' - dumped 5 ske cement -  
pumped in 20 ske mud and 90 ske cement by Sun Cementing Co.  
waited till next day - dumped 5 ske cement on top

RECEIVED  
FEB 15 1956  
2-13-56

(If additional description is necessary, use BACK of this sheet)

Name of Plugging Contractor R&D Casing Pulling Co. License 236  
Address Box 569 Ellinwood, Kansas

STATE OF Kansas, COUNTY OF Barton, ss.  
Nathan Moltzer (employee of owner) or (owner or operator) of the above-described well, being first duly sworn on oath, says: That I have knowledge of the facts, statements, and matters herein contained and the log of the above-described well as filed and that the same are true and correct. So help me God.

(Signature) Nathan Moltzer  
Box 414, Gt. Bend, Kas.  
(Address)

SUBSCRIBED AND SWORN TO before me this 7th day of February, 19 56

My commission expires 3-30-57 \_\_\_\_\_ Notary Public.

PLUGGING  
FILE SEC 31 T 21 R 15 W  
BOOK PAGE 31 LINE 25


WELL LOG BUREAU--KANSAS GEOLOGICAL SOCIETY  
503 East Murdock, Wichita, Kansas

Company- WELCH & OLSSON DRILLING CO., INC.  
Farm- Robert No. 1

SEC. 31 T. 21 R. 15W  
NE NW SE

Total Depth. 3915'  
Comm. 2-5-54 Comp. 2-16-54  
Shot or Treated.  
Contractor. Welch & Olsson Drilling Co., Inc.  
Issued. 5-8-54

County Pawnee  
KANSAS

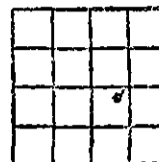

CASING:  
8 5/8" 568' com w/350 sx

Elevation. 1986' BB

Production. Pmp. 6 B & 5 Water

Figures indicate Bottom of Formations.

surface, soil & sand	85
shale & shells	215
shale	385
sand	490
shale & red bed	545
red bed	890
red bed & shale	953
anhydrite	980
shale & shells	1985
lime of shale stks	2170
lime & shale	2310
shale & shells	2875
lime	3335
lime & shale	3520
lime	3760
conglomerate	3796
lime	3805
cherty conglomerate	3863
conglomerate	3864
sand	3909
lime	3915
Total Depth	

Tops:	
Anhydrite	953
Heebner	3367
Toronto	3385
B. Lime	3483
Lansing	3494
Base Kansas City	3728
Conglomerate	3757
Cherty Conglomerate	3810
Viola	3818
Simpson	3864
Arbuckle	3909

RECEIVED  
STATE OF KANSAS COMMISSION

JAN 17 1955

CONSERVATION  
Wichita, Kan.

**PLUGGING**  
FILE SEC 31 T 21 R 15w  
BOOK PAGE 31 LINE 25