

STATE OF KANSAS
STATE CORPORATION COMMISSION

WELL PLUGGING RECORD


Give All Information Completely
Make Required Affidavit
Mail or Deliver Report to:
Conservation Division
State Corporation Commission
500 Bittling Building
Wichita, Kansas

OR

FORMATION PLUGGING RECORD

Strike out upper line
when reporting plug-
ging off formations.

Pawnee County. Sec. 30 Twp. 21 Rge. (E) 15 (W)
Location as "NE 1/4 NW 1/4 SW 1/4" or footage from lines NE NE NW 1/4
Lease Owner Armer Drilling Company, Inc.
Lease Name Vratil Well No. 1
Office Address 306 Insurance Bldg., Wichita, Kansas
Character of Well (completed as Oil, Gas or Dry Hole) dry
Date well completed Dec. 1 19 48
Application for plugging filed Dec. 1 19 48
Application for plugging approved Dec. 1 19 48
Plugging commenced Dec. 1 19 48
Plugging completed Dec. 1 19 48
Reason for abandonment of well or producing formation dry

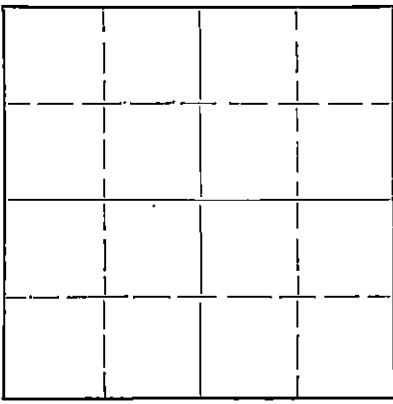

Locate well correctly on above
Section Plat

If a producing well is abandoned, date of last production 19
Was permission obtained from the Conservation Division or its agents before plugging was com-
menced? Yes

Name of Conservation Agent who supervised plugging of this well C. D. Stough
Producing formation Arbuckle Depth to top 3905 Bottom 3955 Total Depth of Well 3955 Feet
Show depth and thickness of all water, oil and gas formations.

OIL, GAS OR WATER RECORDS

CASING RECORD

Formation	Content	From	To	Size	Put In	Pulled Out
				8-5/8"	960'	none

Describe in detail the manner in which the well was plugged, indicating where the mud fluid was placed and the method or methods used in introducing it into the hole. If cement or other plugs were used, state the character of same and depth placed, from feet to feet for each plug set.

Filled hole with heavy mud - bottom plug at 200 ft. with 15 sacks cement. Filled hole again & top plug at 20 ft. with 10 sacks cement.

DEC 1 1948
12-11-48
DIVISION
KANSAS

(If additional description is necessary, use BACK of this sheet)

Correspondence regarding this well should be addressed to Armer Drilling Company, Inc.
Address 306 Insurance Bldg., Wichita, Kansas

STATE OF Kansas COUNTY OF Sedgwick, ss.


M. B. Armer, Pres. of Armer Drilling Company, Inc. (owner or operator) of the above-described well, being first duly sworn on oath, says: That I have knowledge of the facts, statements, and matters herein contained and the log of the above-described well as filed and that the same are true and correct. So help me God. Armer Drilling Company, Inc.

(Signature) By M. B. Armer
President
306 Insurance Bldg., Wichita 2, Kansas
(Address)

SUBSCRIBED AND SWORN to before me this 9th day of December, 19 48

Wegh. Walton
Notary Public.

My commission expires Sept. 17, 1951

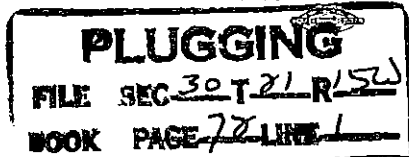

Company: ~~MYXX~~ Armer Drilling Company, Inc. Farm: Vratil #1
 Contractor: Armer Drilling Company, Inc. Location: NE NE NW $\frac{1}{4}$
 Date Commenced: 11/10/48 Sec. 30-21S-15W, Pawnee County,
 Date Completed: 12/1/48 Kansas
 Elevation: 1967 D. F. Casing Record:
 Rig #2 960' of 8-5/8" @ 944

(Figures below indicate bottoms)

Surface soil sand & gravel	70
Sand, shale & shells	235
Shale & shells	300
Shale	370
Sand & red bed	455
Shale & red bed	555
Shale, shells & red bed	660
Red bed	880
Red bed(pyrite streaks)	927
Anhydrite	955
Shale	1120
Shale & red bed	1200
Shale & shells	1940
Shale & lime	2140
Sand	2183
Lime & shale	2655
Brkn. lime & shale	2760
Shale & lime	2855
Lime	2910
Lime & shale	2995
Lime	3530
Cherty lime	3565
Lime	3670
Lime, cherty	3720
Lime	3785
Cherty conglomerate	3820
Chert & lime	3835
Cherty conglomerate	3885
Lime & shale	3925
Lime, Arb.	3955
-- Total Depth	3955 D & A

RECEIVED

DEC 11 1948

STATE REGISTRATION
 COMMISSION
 KANSAS

I hereby certify that this is a true and correct log of the above described well as shown by the drilling reports.

Armer Drilling Company, Inc.

By M. B. Armer

State of Kansas)

County of Sedgwick)

SS

PLUGGING
 FILE SEC 30 T 21 R 15W

Subscribed and sworn to before me, a Notary Public, in and for said County and State this 8th day of December, 1948.

Hazel Walton
 Notary Public.

My commission expires Sept. 17, 1951